Not on 13K.

IREDELL COUNTY HEALTH DEPARTMENT

Statesville Phone TR 3-7271 Mooresville Phone NO 3-1271

PERMIT TO INSTALL SEPTIC TANK

Permit No. _____ Permit Date Dec 10-11 19 71

Owner Jet B-B Restaurant Address Troutman

Installed By Harlan Jackson Address Cooks Store Rt 2

Location of Property Troutman. across from Fair Grounds.


Repair Job.

Tank		Capacity		Length of Lines		Fixtures	
Block	( )	1000	( )	225'	( )	No. of Baths	( )
Precast	( )	1250	( )	250'	( )	Dishwasher	( )
		1500	( )	Other _____		Garbage Grdr.	( )
		Other _____				Other _____	

NOTIFY HEALTH DEPARTMENT AT LEAST EIGHT HOURS BEFORE TANK IS TO BE INSPECTED.

Final Inspection _____ 19___ Approved ( ) Disapproved ( )

Remarks No. 1 Hole. 24 Tons. Stone No 2. 32 tons, No 3 - 46 tons 2 Loads of Cement Broken Bricks, Cement, Blocks

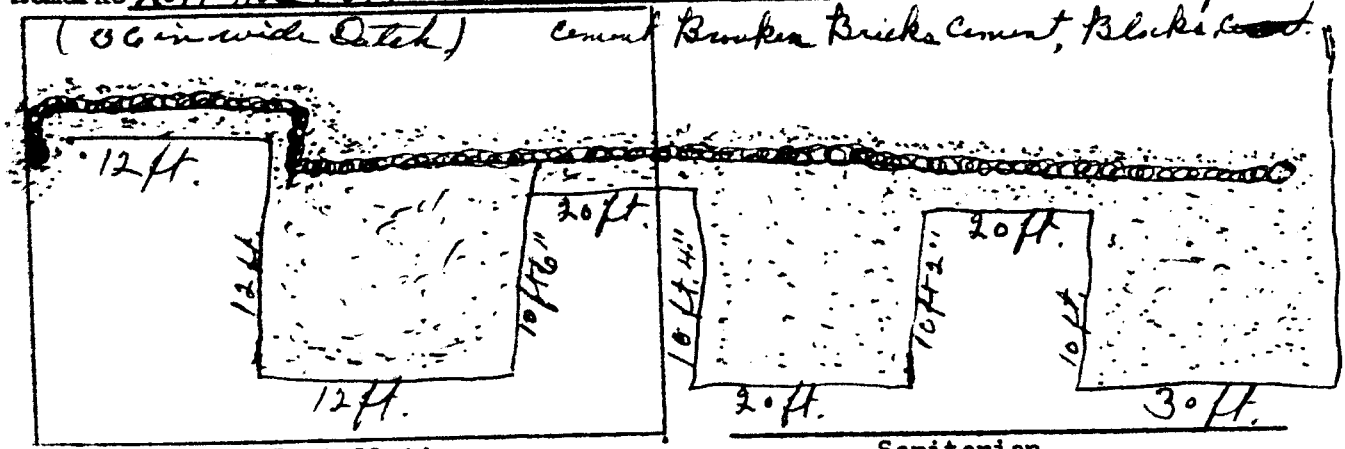

Sketch of Installation

Sanitarian