IREDELL COUNTY HEALTH DEPARTMENT

Statesville Office (704) 878-5305 Mooresville Office (704) 660-3625 PERMIT # 206188

IMPROVEMENT PERMIT / AUTHORIZATION TO CONSTRUCT / OPERATION PERMIT / EXISTING SYSTEM

PIN # 4732607043

APPLICANT: Jennie Clontz APPLICANT ADDRESS: 111 Old Mountain Rd

SITE ADDRESS: 111 old Mountain Rd PHONE: 704-528-5290 ALT. PHONE: N/A

SITE DIRECTIONS: Corner of old Mountain Rd + 21

SUBDIVISION: N/A SECTION: N/A LOT # N/A LOT AREA: 2.55ac DESIGN FLOW: 240 L.T.A.R.: 0.15


Septic Tank 1000 (gal) STB 760 Date 6-32-14
Pump Tank N/A (gal) PT N/A Date N/A
Pump Make N/A Model Pow/Mk Serial # PL-66
Nitrification Fields 1 # Lines 5 Linear Ft: 400
Trench Width 36" Max. Trench Bottom Depth 12" Gravel Depth N/A

☐ New System ☒ Repair ☐ Expansion System Type: I II III IV V VI
System Description: Shallow 25% Reduction w/cap
Repair System Description:
Maintenance Agreement Required: ☐ YES ☒ NO
☒ GRAVITY ☐ PRESSURE

☒ Residence ☐ Business ☐ Other ☐ Slab ☒ Crawl Space ☐ Basement w/plumbing ☐ Basement w/o plumbing
No. Bedrooms 2 No. Persons 4 No. Employees
Water Supply: ☒ Private ☒ Public ☐ Community

Comments / Conditions: Check tank, check tee, replace if necessary
Install 25% reduction on contour with serial distribution
Bring in 10" of cover Extend cover 5' past all drain lines.

INITIAL SITE SKETCH

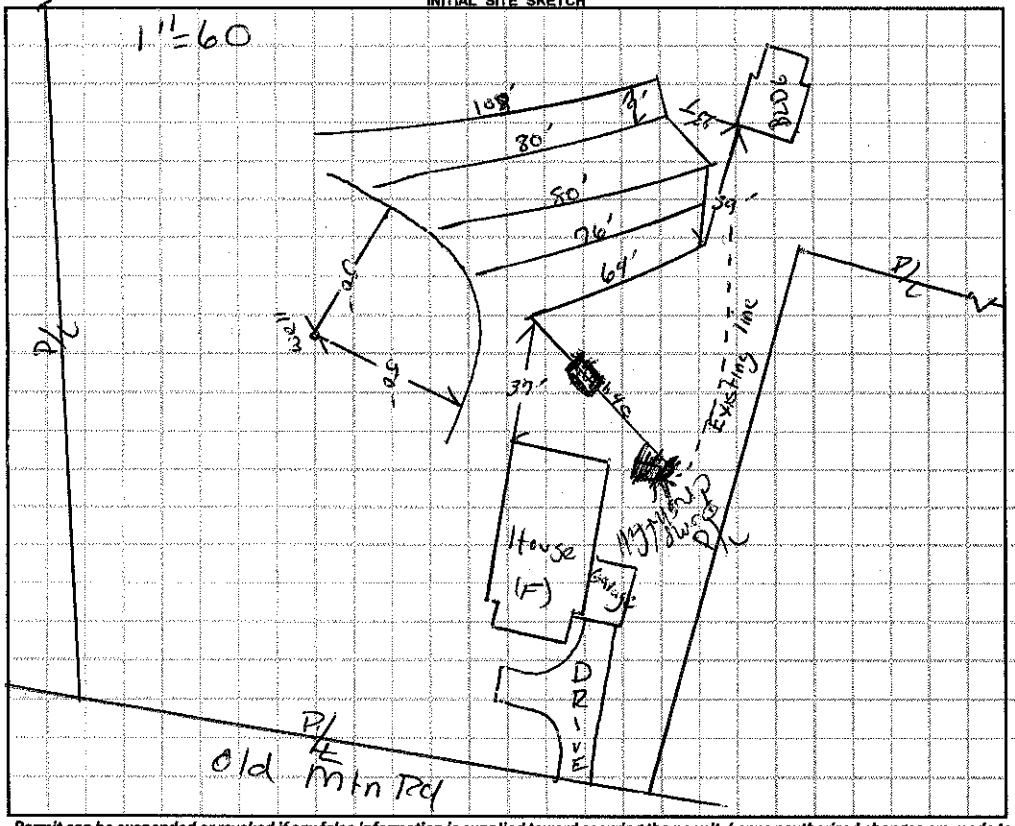

AS BUILT SKETCH

Installed Rock 4 as drawn

Permit can be suspended or revoked if any false information is supplied toward securing the permit / any unauthorized changes are made to the site / any unauthorized changes are made in the installation of the system. **CONTACT A LOCATOR SERVICE PRIOR TO ANY EXCAVATION**

☐ **IMPROVEMENT PERMIT** *with plat valid without expiration.* ☒ **IMPROVEMENT PERMIT** *with site plan valid for 60 mos.* ☑ **AUTHORIZATION TO CONSTRUCT** *valid for period equal to IMPROVEMENT PERMIT--not to exceed 60 mo.*

Owner / Applicant Signature: Jennie Clontz Date: 10-10-14 Installed by: A-1 Septic

IMPROVEMENT PERMIT by: Date: 10/09/14 OPERATION PERMIT by: Date: 10/10/14

AUTHORIZATION TO CONSTRUCT by: Date: 10/09/14 Existing System Inspected by: Date:

Health Dept. Copy - WHITE Applicant (Final Approval) - YELLOW Applicant (Conditional Approval) - PINK