IREDELL COUNTY HEALTH DEPARTMENT

Statesville Phone TR 3-7271 Mooresville Phone NO 3-1271

PERMIT TO INSTALL SEPTIC TANK

Permit NO. _____ Permit Date Aug 15 1963

Owner cafe & beer joint Address 21 South

Installed By C Hoke Address _____


Location of Property Across from Fair ground

Tank		Capacity		Length of Lines		Fixtures	
Block	( )	800	( )	150'	( )	No. of Baths	(2) Stool
Precast	(✓)	900	( )	175'	( )	Dishwasher	( )
		1000	(●)	200'	( )	Garbage Grdr.	( )
		1100	( )	225'	(●)	Auto-Washer	( )
		1200	( )	250'	( )	Other _____	
		Other 1250 gal		Other 350			

NOTIFY HEALTH DEPARTMENT AT LEAST EIGHT HOURS BEFORE TANK IS TO BE INSPECTED.

Final Inspection 8-15 1963 Approved (✓) Disapproved ( )

Remarks well

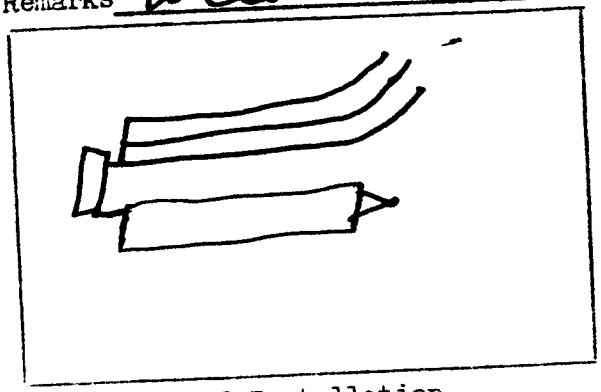

Sketch of Installation

Rut.

Sanitarian