IREDELL COUNTY HEALTH DEPARTMENT

STATESVILLE 704-878-5305 MOORESVILLE 704-664-5281

IMPROVEMENT PERMIT / AUTHORIZATION TO CONSTRUCT / OPERATION PERMIT / EXISTING SYSTEM INSPECTION

PERMIT# Repair PIN# DATE 4-14-99

OWNER OR CONTRACTOR William Ladd PHONE: Business Home

ADDRESS 163 Barium Ln Statesville

LOCATION 215 TR Barium Ln House on (L) Box 163

SUBDIVISION BLOCK / SECTION LOT LOT AREA SITE CLASS P/S DESIGN FLOW 240 L.T.A.R. 0.25

Septic Tank: 1000 Existing Gallons; STB Date

Pump Tank: Gallons; PT Date

Pump Make: Model Serial No.

Nitrification Field: No Fields 1 Square Feet Linear Feet

No Lines 3 Trench Width 36in Max Trench Bottom Depth 20-24in Gravel Depth 12in

☐ New System ☒ Repair System Type: I (II) III. IV. V. VI

System Description:

Repair System Description: Gravity Convention

Maintenance Agreement Required: ☐ Yes ☐ No

☐ House/Mod. Home ☐ Mobile Home ☐ Business ☐ Other

No. Bedrooms 2 No. Bathrooms 1 No. Employees

☐ Slab ☒ Crawl Space ☐ Basement w/plumbing ☐ Basement wo/plumbing


Water Supply: ☒ Individual ☐ Public ☐ Community shared well

Comments/Conditions: Installed 3 Lines 9ft on center 20-24in Deep Trenches


This permit serves as Notice of Violation

Comments/Conditions

INITIAL SITE SKETCH

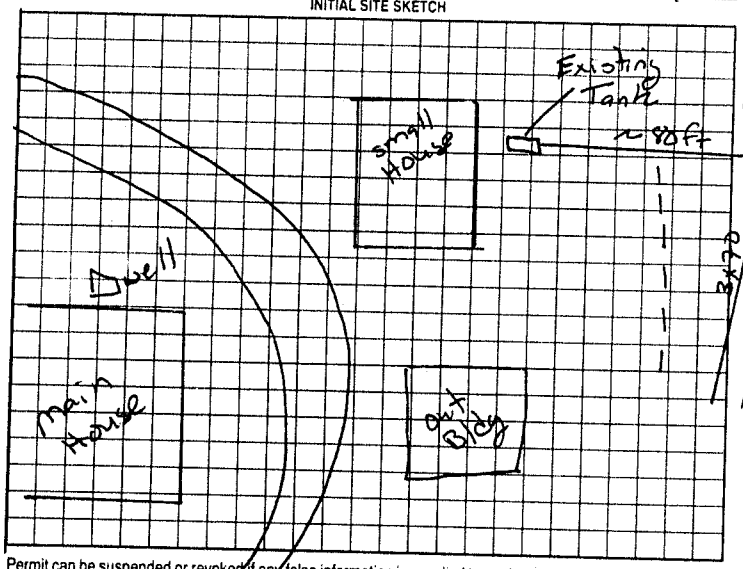

AS BUILT SKETCH

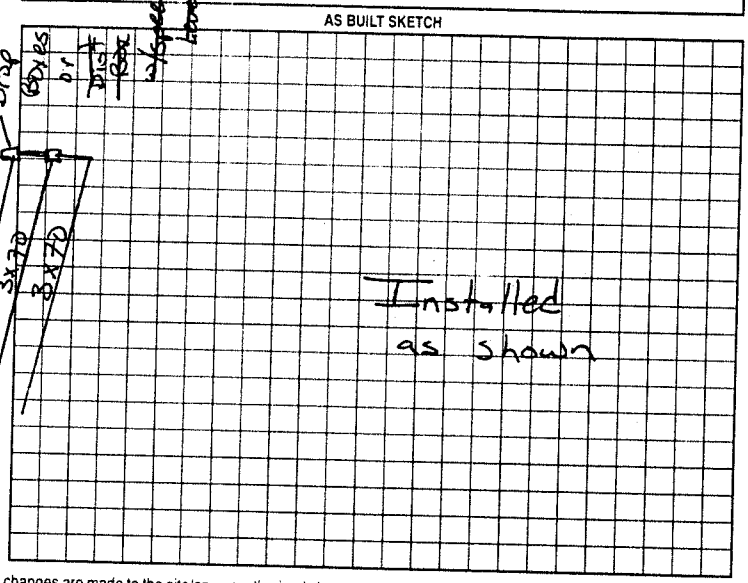

Permit can be suspended or revoked if any false information is supplied toward securing the permit/any unauthorized changes are made to the site/any unauthorized changes are made in the installation of the system. Improvement Permit with plat valid without expiration. Improvement Permit with site plan valid for sixty months. Authorization to Construct is valid for a period equal to that of Improvement Permit – not to exceed sixty months.

Signed: William A Ladd date 4-14-99

Improvement Permit by: Mark C Ort RS date 4-14-99

Authorization to Construct by: Mark C Ort RS date 4-14-99

Installed by: Wess Lytton

Operation Permit by: Mark C Ort RS date 5-11-99

Existing System Inspection by: date

HEALTH DEPT COPY: WHITE OWNER COPY (FINAL): YELLOW OWNER COPY (INITIAL): PINK