IREDELL COUNTY HEALTH DEPARTMENT

(SEPTIC TANK) IMPROVEMENTS PERMIT AND CERTIFICATE OF COMPLETION
(Ground Absorption Sewage Disposal System – G. S. Chapter 130-Article 13C)

OWNER OR CONTRACTOR Tony Parker DATE 4-13-83 PERMIT NO. _____

PHONE: Business _____ Home _____

LOCATION Old Mtn. Rd. from Troutman, T.R. on Barium Circle - 4th house on (R). S. R. No. _____

SUBDIVISION NAME _____ LOT NO. _____ SECTION OR BLOCK NO. _____

House (✓) Mobile Home ( ) Business ( ) Other Repair


No. Bedrooms _____ No. Bathrooms _____

Garbage Disposal Unit	Yes ( )	No ( )
Auto. Dishwasher	Yes ( )	No ( )
Auto. Wash. Machine	Yes ( )	No ( )
Site Suitable	Yes ( )	No ( )

Character & Porosity of Soil _____
Percolation Rate _____
Topography Repair
Depth to Water Table _____
Rock or other impervious formations _____

Lot Area Ample

_____ Basement with Plumbing _____ Basement without Plumbing ✓ No Basement

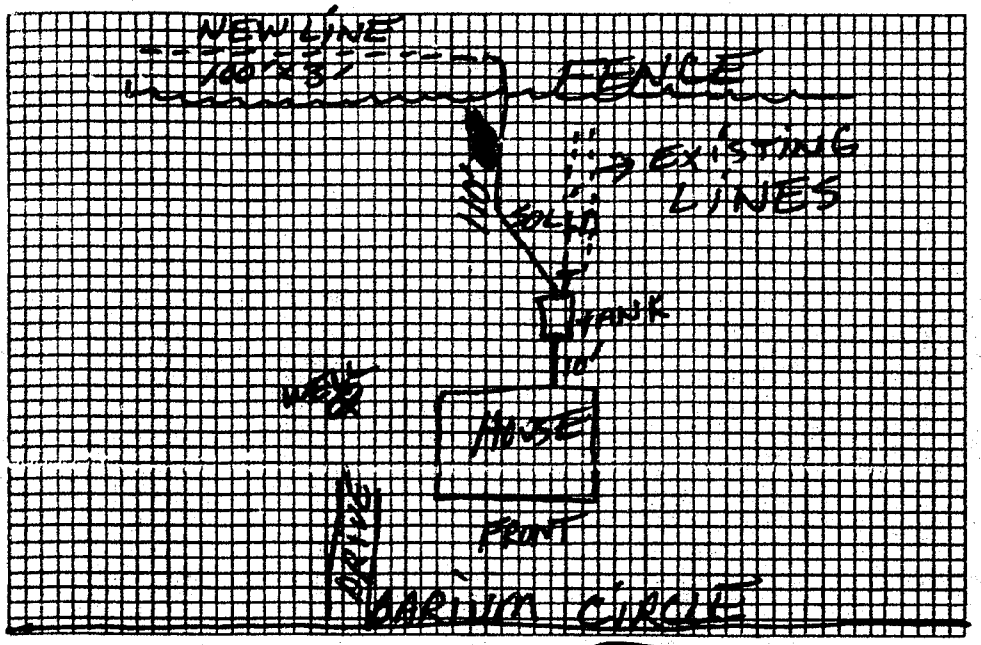

Plan of System

Size of Tank EXISTING Gals.
Nitrification Field:
No. of Lines 1
Sq. Ft. 300 Linear Ft. 100
Depth of Stone in Lines 16"
Water Supply: Individual (✓)
Public ( )

Installed by Robert Hoke

I understand and agree to install septic tank system as specified on this Improvements Permit.

Signed: _____

IMPROVEMENTS PERMIT BY Steve Brown

COMMENTS: New tank installed. old lines abandoned.

CERTIFICATE OF COMPLETION BY Steve Brown DATE 4-13-83

EXISTING SYSTEM CHECKED BY: _____ DATE _____

CONSTRUCTION MUST COMPLY WITH ALL OTHER APPLICABLE STATE AND LOCAL REGULATIONS.
Permit is VOID if any unauthorized changes are made in installation of system and/or if any false information is supplied in making Improvements Permit.

Health Dept. Copy: White Inspection Dept. Copy: Yellow Sanitarian's Copy: Pink Owner's Copy: Gold