IREDELL COUNTY HEALTH DEPARTMENT

Statesville Phone TR 3-7271 Mooresville Phone NO 3-1271

PERMIT TO INSTALL SEPTIC TANK

Permit NO. _____ Permit Date MAY 14 1958

Owner CLAUDE MONDAY Address BARIUM SPRINGS

Installed By R.C. OSTWALT Address _____


Location of Property DOWN #21 JUST PAST BARIUM SPGS 1st RIGHT 3rd HOUSE ON LEFT

Tank		Capacity		Length of Lines		Fixtures	
Block	(✓)	800	( )	150'	( )	No. of Baths	(1)
Precast	( )	900	( )	175'	( )	Dishwasher	(1)
		1000	(✓)	200'	( )	Garbage Grdr.	( )
		1100	( )	225'	(✓)	Auto-Washer	( )
		1200	( )	250'	( )	Other _____	
		Other _____		Other _____			

NOTIFY HEALTH DEPARTMENT AT LEAST EIGHT HOURS BEFORE TANK IS TO BE INSPECTED.

Final Inspection MAY 14 1958 Approved (✓) Disapproved ( )

Remarks _____

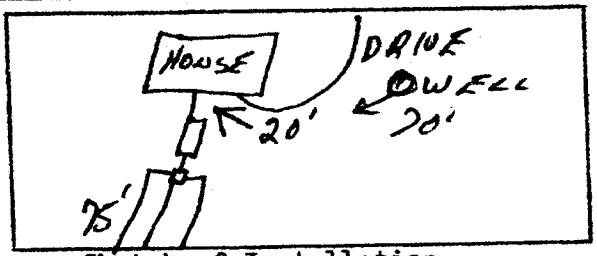

Sketch of Installation

Rayford A. Thomas

Sanitarian