IREDELL COUNTY HEALTH DEPARTMENT

STATESVILLE 704-878-5305 MOORESVILLE 704-664-5281

IMPROVEMENT PERMIT / AUTHORIZATION TO CONSTRUCT / OPERATION PERMIT / EXISTING SYSTEM INSPECTION

PERMIT# REPAIR PIN# 4732-66-5647 DATE 6-01-09

OWNER OR CONTRACTOR PATTI MOUNTS PHONE: Business Home 704-873-3237

ADDRESS 118 PINE HAVEN ROAD STATESVILLE, NC 28677

LOCATION US 21 SOUTH, TR PINE HAVEN ROAD, BEAR LEFT AT INTERSECTION, 1ST HOUSE ON RIGHT

SUBDIVISION MARGROLL ACRES BLOCK / SECTION LOT 34 LOT AREA LIMITED SITE CLASS PS DESIGN FLOW 480' L.T.A.R. 0.30 GPD/FT²

Septic Tank: 75 Gallons: STB Date
Pump Tank: WASHER BOX Gallons: PT Date
Pump Make: Model Serial No.
Nitrification Field: No Fields 1 Square Feet 210 Linear Feet 70
No Lines TWO Trench Width 36" Max Trench Bottom Depth 36" Gravel Depth 24"


☒ ~~New System~~ ☒ Repair System Type: I, II, III, IV, V, VI
System Description:
Repair System Description: CONVENTIONAL GRAVITY
Maintenance Agreement Required: ☐ Yes ☒ No

☒ House/Mod. Home No. Bedrooms 4
☐ Mobile Home No. Bathrooms 2
☐ Business No. Employees
☐ Other
☐ Slab ☐ Crawl Space ☒ Basement w/plumbing ☐ Basement wo/plumbing


Water Supply: ☒ Individual ☐ Public ☐ Community
WELL

Comments:/Conditions: ① INSTALL NEW WASHER BOX AT LOCATION SHOWN USING ONE DROP BOX TO SERIALLY FEED TWO NEW LINES AS SHOWN USING 24" STONE. ② THIS PERMIT SERVES AS "NOTICE OF VIOLATION", SYSTEM TO BE REPAIRED BY 7-1-04

INITIAL SITE SKETCH

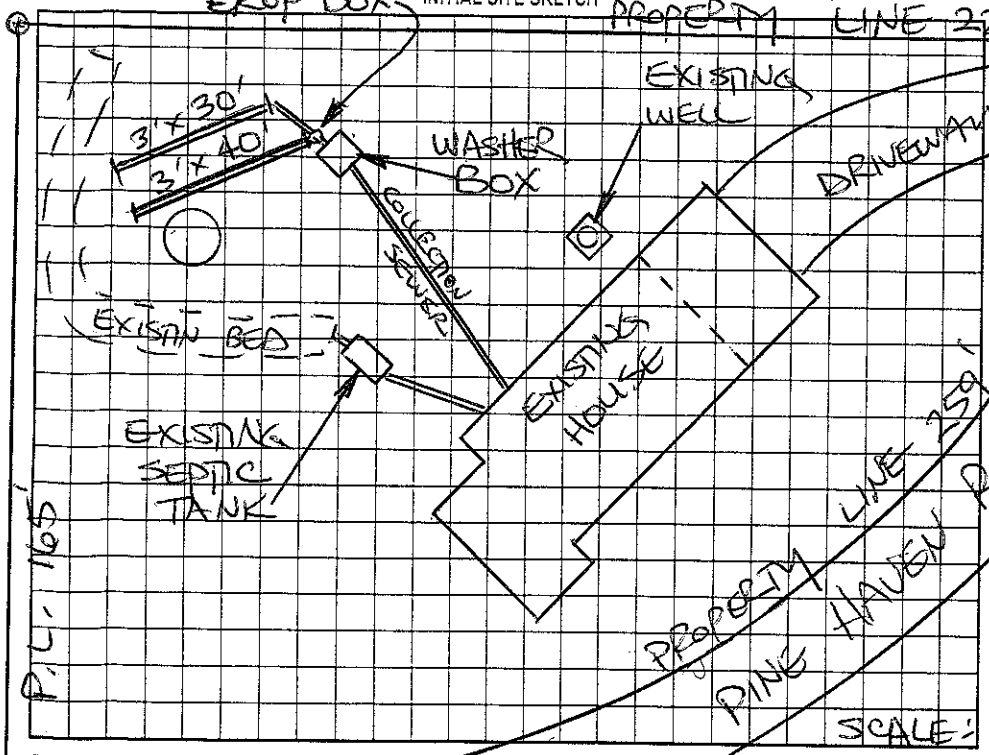

AS-BUILT SKETCH

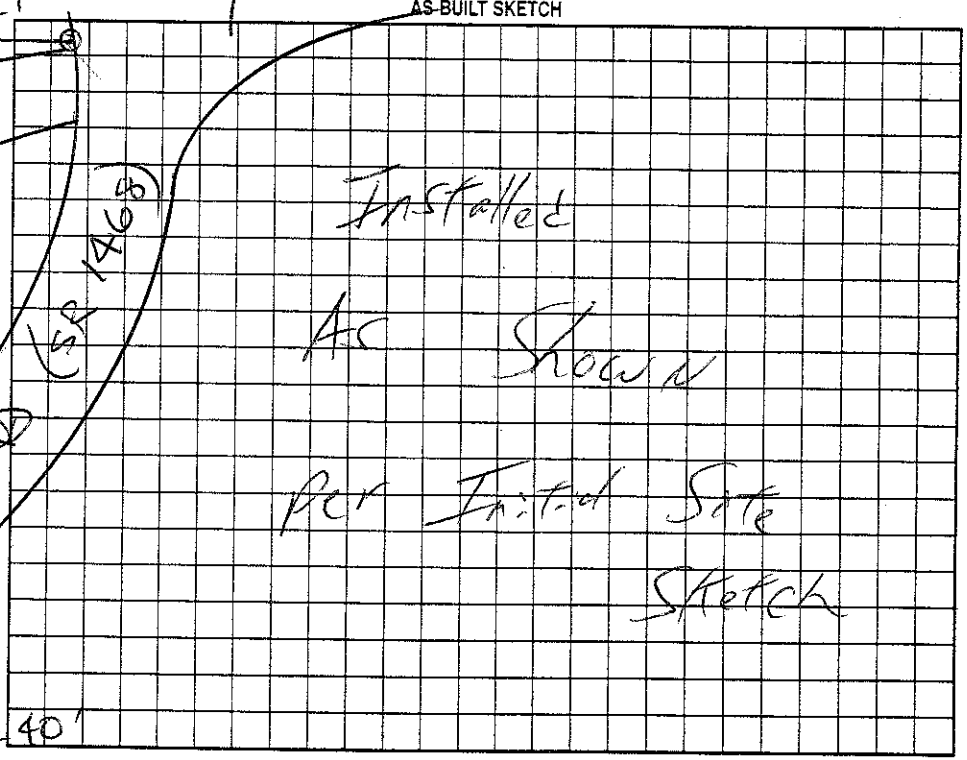

Permit can be suspended or revoked if any false information is supplied toward securing the permit/any unauthorized changes are made to the site/any unauthorized changes are made in the installation of the system. Improvement Permit with plat valid without expiration. Improvement Permit with site plan valid for sixty months. Authorization to Construct is valid for a period equal to that of Improvement Permit -- not to exceed sixty months.

Signed: X Patti Mounts date 6/1/04 Installed by: Patti Mounts (Frank Williams)

Improvement Permit by: STEVE HEDRICK date 6-1-04 Operation Permit by: William O. Johnson date 6/25/04

Authorization to Construct by: STEVE HEDRICK date 6-1-04 Existing System Inspection by: date

HEALTH DEPT. COPY: WHITE OWNER COPY (FINAL): YELLOW OWNER COPY (INITIAL): PINK