IREDELL COUNTY HEALTH DEPARTMENT

STATESVILLE 704-878-5305 MOORESVILLE 704-664-5281

IMPROVEMENT PERMIT / AUTHORIZATION TO CONSTRUCT / OPERATION PERMIT / EXISTING SYSTEM INSPECTION

PERMIT# PIN# DATE 5-3-99

OWNER OR CONTRACTOR Jessie mounts PHONE: Business Home 873 3232

ADDRESS 118 Pine Haven Rd

LOCATION 215 TR Pine Haven Stay left at Forks

SUBDIVISION BLOCK / SECTION LOT LOT AREA SITE CLASS. DESIGN FLOW L.T.A.R. .3

Septic Tank: EX 1000 Gallons; STB Date

Pump Tank: Gallons; PT Date

Pump Make: Model Serial No.

Nitrification Field: No Fields 1 Square Feet 540 Linear Feet 180

No Lines 2 Trench Width 72" Max Trench Bottom Depth 36" Gravel Depth 18"

☐ New System ☑ Repair System Type: I, (II), III, IV, V, VI

System Description:

Repair System Description: Gravity Convential

Maintenance Agreement Required: ☐ Yes ☐ No

☑ House/Mod. Home No. Bedrooms 3

☐ Mobile Home No. Bathrooms 2

☐ Business No. Employees

☐ Other


☐ Slab ☐ Crawl Space ☐ Basement w/plumbing ☐ Basement wo/plumbing

Water Supply: ☑ Individual ☐ Public ☐ Community


Comments/Conditions: This Permit Replaces one issued 9-2-98 Due To Cost + Placing

Comments/Conditions

INITIAL SITE SKETCH

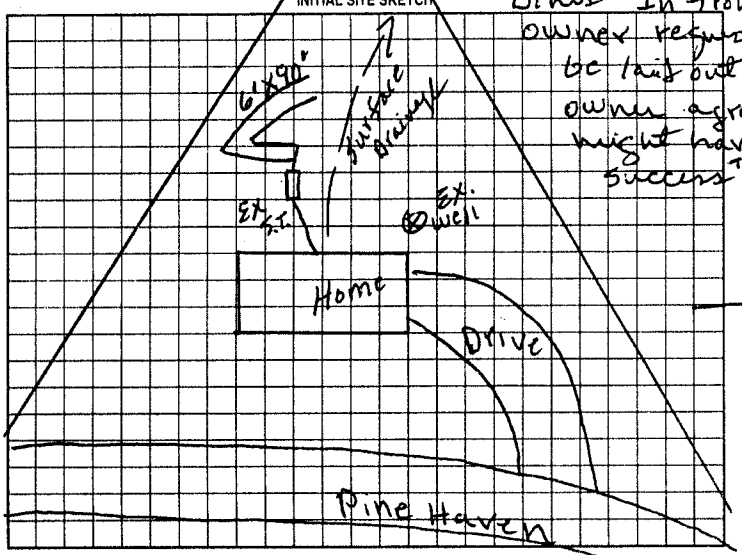

AS BUILT SKETCH

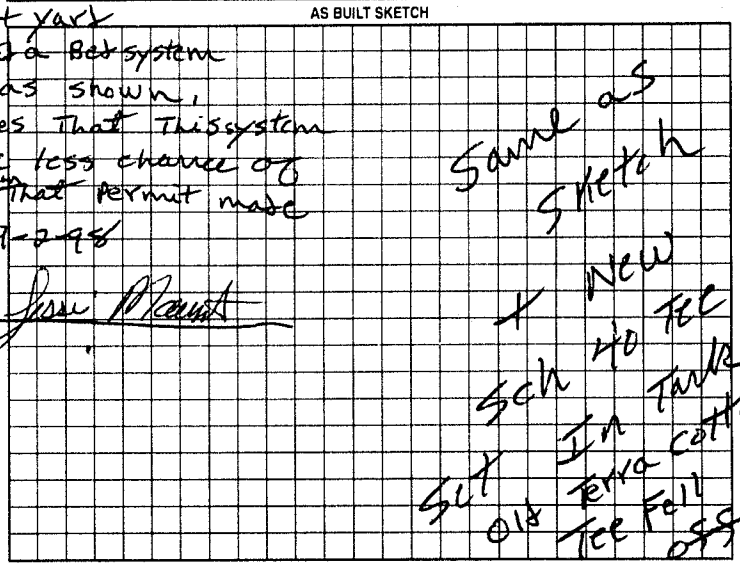

Permit can be suspended or revoked if any false information is supplied toward securing the permit/any unauthorized changes are made to the site/any unauthorized changes are made in the installation of the system. Improvement Permit with plat valid without expiration. Improvement Permit with site plan valid for sixty months. Authorization to Construct is valid for a period equal to that of Improvement Permit – not to exceed sixty months.

Signed: Jessie Mounts date

Installed by: C+W Grading

Improvement Permit by: P.C. moore date 5-3-99

Operation Permit by: P.C. moore date 5-5-99

Authorization to Construct by: P.C. moore date 5-3-99

Existing System Inspection by: date

HEALTH DEPT COPY WHITE OWNER COPY (FINAL) YELLOW OWNER COPY (INITIAL) PINK