IREDELL COUNTY HEALTH DEPARTMENT

Statesville Phone TR 3-7271 Mooresville Phone No. 664-5281

PERMIT TO INSTALL SEPTIC TANK

Permit No. 477 Permit Date 6-4 1973

Owner Banks Brown Address Statesville N.C.

Installed By Lackey Bro Address Stony Point


Location of Property Hwy 21 S. T.R. on Rd 1468 at top of hill Past Iredell Memorial Park Cemetery House on L - Rock Front.

Tank		Capacity		Length of Lines		Fixtures	
Block	( )	1000	(✓)	225'	( )	No. of Baths	(2)
Precast	(✓)	1250	( )	250'	( )	Dishwasher	(✓)
		1500	( )	Other 246		Garbage Grdr.	( )
		Other				Other	

NOTIFY HEALTH DEPARTMENT AT LEAST EIGHT HOURS BEFORE TANK IS TO BE INSPECTED.

Final Inspection 6-4 1973 Approved (✓) Disapproved ( )

Remarks Well more than 100' away

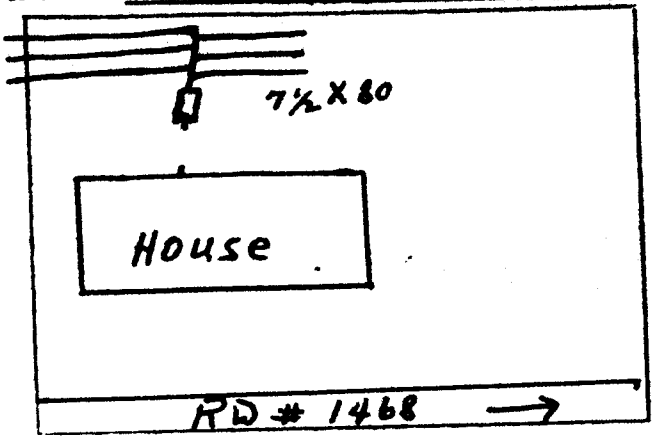

Sketch of Installation

E. G. Stevenson

Sanitarian