IREDELL COUNTY HEALTH DEPARTMENT

Statesville Phone TR 3-7271 — Mooresville Phone NO 3-1271

PERMIT TO INSTALL SEPTIC TANK

Permit NO. Smith Pg. — Permit Date 5 - 18 - 1962

Owner Hugh Shaver daughter — Address RT -

Installed By C Hoke — Address R)


Location of Property on hill before B. Springs on 21 S. past dredell mor. Park cem.

Tank		Capacity		Length of Lines		Fixtures	
Block	( )	800	( )	150'	( )	No. of Baths	(1)
Precast	(✓)	900	( )	175'	( )	Dishwasher	( )
		1000	(✓)	200'	( )	Garbage Grdr.	( )
Cash		1100	( )	225'	(✓)	Auto-Washer	(✓)
		1200	( )	250'	( )	Other	
		Other		Other			

NOTIFY HEALTH DEPARTMENT AT LEAST EIGHT HOURS BEFORE TANK IS TO BE INSPECTED.

Final Inspection 5-18-1962 — Approved (✓) Disapproved ( )

Remarks ditch 7½' wide - hard fall. well 50'

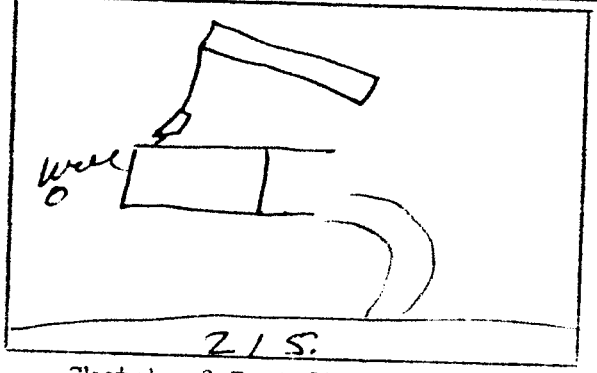

Sketch of Installation

Pat

Sanitarian