IREDELL COUNTY HEALTH DEPARTMENT

Statesville Phone TR 3-7271 — Mooresville Phone NO 3-1271

PERMIT TO INSTALL SEPTIC TANK

Permit NO. _____ Permit Date NOV 18 1960

Owner E. L. SHAVER (CHAIR CO.) Address TROUTMAN N.C.

Installed By OSTWALT Address _____

Location of Property DOWN #21 EAST JUST BEFORE BARIUM ON RIGHT


Tank		Capacity		Length of Lines		Fixtures	
Block	(✓)	800	( )	150'	( )	No. of Baths	( )
Precast	( )	900	( )	175'	( )	Dishwasher	( )
		1000	( )	200'	( )	Garbage Grdr.	( )
		1100	( )	225'	( )	Auto-Washer	( )
		1200	( )	250'	( )	Other _____	
		Other 2000		Other 350'			

NOTIFY HEALTH DEPARTMENT AT LEAST EIGHT HOURS BEFORE TANK IS TO BE INSPECTED.

Final Inspection NOV 18 1960 Approved (✓) Disapproved ( )

Remarks FOR ADDITION TO PLANT

NO WATER SUPPLY INVOLVED!

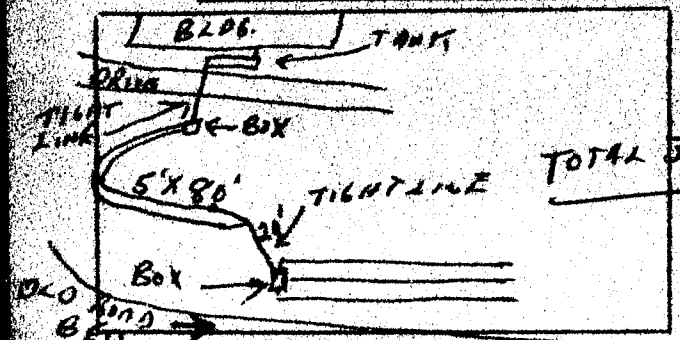

Sketch of Installation

Raymond A. Thomas

Sanitarian