IREDELL COUNTY HEALTH DEPARTMENT

STATESVILLE 704-878-5305 MOORESVILLE 704-664-5281

IMPROVEMENT PERMIT / CERTIFICATE OF COMPLETION / OPERATION PERMIT / EXISTING SYSTEM INSPECTION

PROPERTY DESCRIPTION NO. 65973 DATE 4-28-97 TAX MAP NO. 4732.69 4771.6 Watershed: ☐ Yes ☒ No

OWNER OR CONTRACTOR Iredell memorial Gardens PHONE: Business 873 7246 Home

ADDRESS 2304 Shelton Ave

LOCATION US 21 South Part 3rd creek on RT behind memorial Gardens

SUBDIVISION BLOCK / SECTION LOT LOT AREA 3 acres SITE CLASS. PS DESIGN FLOW 100gal L.T.A.R. .3

Septic Tank: 1000 Gallons; STB 794 Date 4-29-97

Pump Tank: Gallons; PT Date

Pump Make: Model Serial No.

Nitrification Field: No Fields 1 Square Feet 450 Linear Feet 150

No Lines 3 Trench Width 36" Max Trench Bottom Depth 24" Gravel Depth 12"

☐ New System ☐ Repair System Type: I, ☒ II, III, IV, V, VI

System Description: Conv. Gravity

Repair System Description: " "

Maintenance Agreement Required: ☐ Yes ☒ No

☐ House/Mod. Home No. Bedrooms

☐ Mobile Home No. Bathrooms 1

☒ Business No. Employees

☐ Other Shop for Gardens

☒ Slab ☐ Crawl Space ☐ Basement w/plumbing ☐ Basement wo/plumbing


Water Supply: ☐ Individual ☐ Community ☒ Public

Comments:


Comments:

* Tank location moved slightly

INITIAL SITE SKETCH

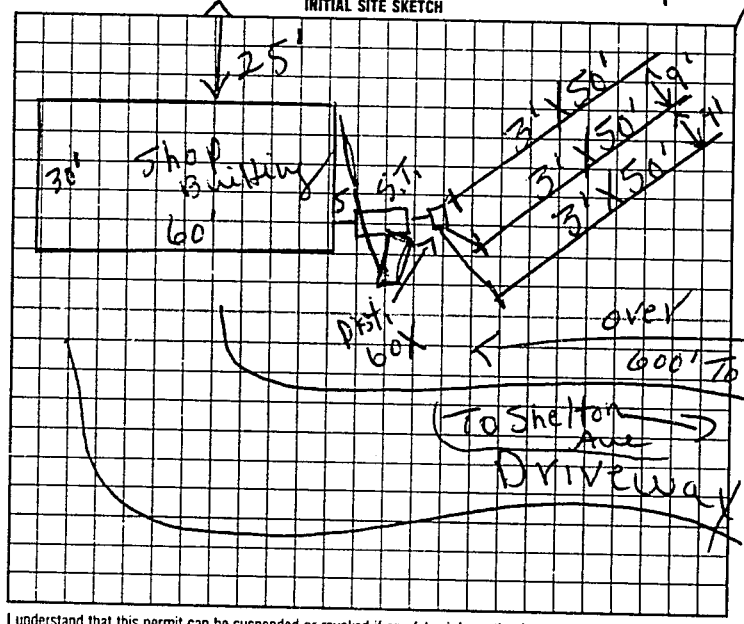

AS BUILT SKETCH

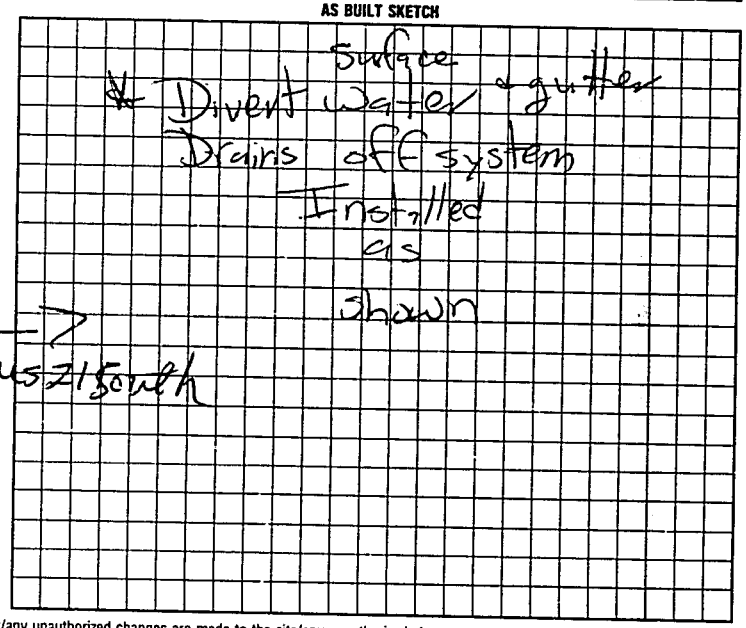

I understand that this permit can be suspended or revoked if any false information is supplied toward securing the permit/any unauthorized changes are made to the site/any unauthorized changes are made in the installation of the system. Improvement Permit is valid for 60 months from date of issuance.

Signed: X Keith Penrson

Improvement Permit by: L.C. Moore date 4-28-97

~~Authorization~~ Existing System Inspection L.C. Moore date 4-28-97

to count. Authorization to count. EXPIRES 60 mos from issue

Installed by: Wess Lytton

Certificate of Completion by: date

Operation Permit by: Mary C Cox RS date 7-15-97

HEALTH DEPT. COPY WHITE INSPECTION COPY (FINAL) GREEN OWNER COPY (FINAL) YELLOW INSPECTION COPY (INITIAL) PINK OWNER COPY (INITIAL) GOLD