IREDELL COUNTY HEALTH DEPARTMENT

STATESVILLE 704-878-5305 MOORESVILLE 704-664-5281

IMPROVEMENT PERMIT / AUTHORIZATION TO CONSTRUCT / OPERATION PERMIT / EXISTING SYSTEM INSPECTION

PERMIT# REPAIR PIN# 4732-76-1487 DATE 4-23-03

OWNER OR CONTRACTOR JAMES F. WALSH PHONE: Business Home 704-873-7037

ADDRESS 2461 SHELTON AVE STATESVILLE NC 28677

LOCATION US 21 SOUTH, HOUSE ON LEFT, AT BOX # 2461

SUBDIVISION BLOCK / SECTION LOT LOT AREA 0.58 ACRE SITE CLASS. PS DESIGN FLOW 360 L.T.A.R. EXISTING

Septic Tank: EXISTING Gallons; STB Date

Pump Tank: Gallons; PT Date

Pump Make: Model Serial No.

Nitrification Field: No Fields 1 Square Feet 360 Linear Feet 120

No Lines THREE Trench Width 36" Max Trench Bottom Depth 36" Gravel Depth (24")

☐ New System ☑ Repair System Type: I, (II), III, IV, V, VI

System Description:

Repair System Description: CONVENTIONAL, GRAVITY

Maintenance Agreement Required: ☐ Yes ☑ No

☑ House/Mod. Home No. Bedrooms 3

☐ Mobile Home No. Bathrooms 1 1/2

☐ Business No. Employees

☐ Other

☐ Slab ☑ Crawl Space ☐ Basement w/plumbing ☐ Basement wo/plumbing


Water Supply: ☐ Individual ☑ Public ☐ Community

Comments:/Conditions: (1) INSTALL NEW 3' x 40' LINES ON CONTOUR AS FLAGGED USING 24" STONE (2) RELOCATE EXISTING GAS LINE AS SHOWN (3) THIS PERMIT SERVES AS "NOTICE OF VIOLATION."


Comments:/Conditions: SYSTEM TO BE REPAIRED BY 5-23-03

EXISTING GAS LINE NOT MOVED

INITIAL SITE SKETCH

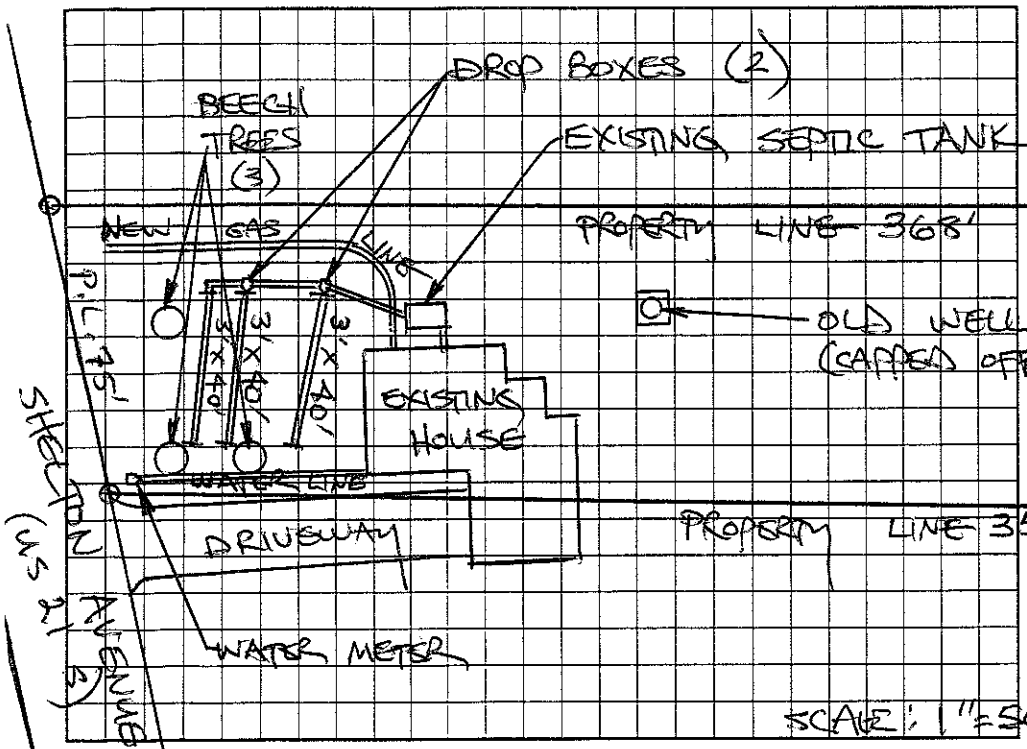

AS BUILT SKETCH

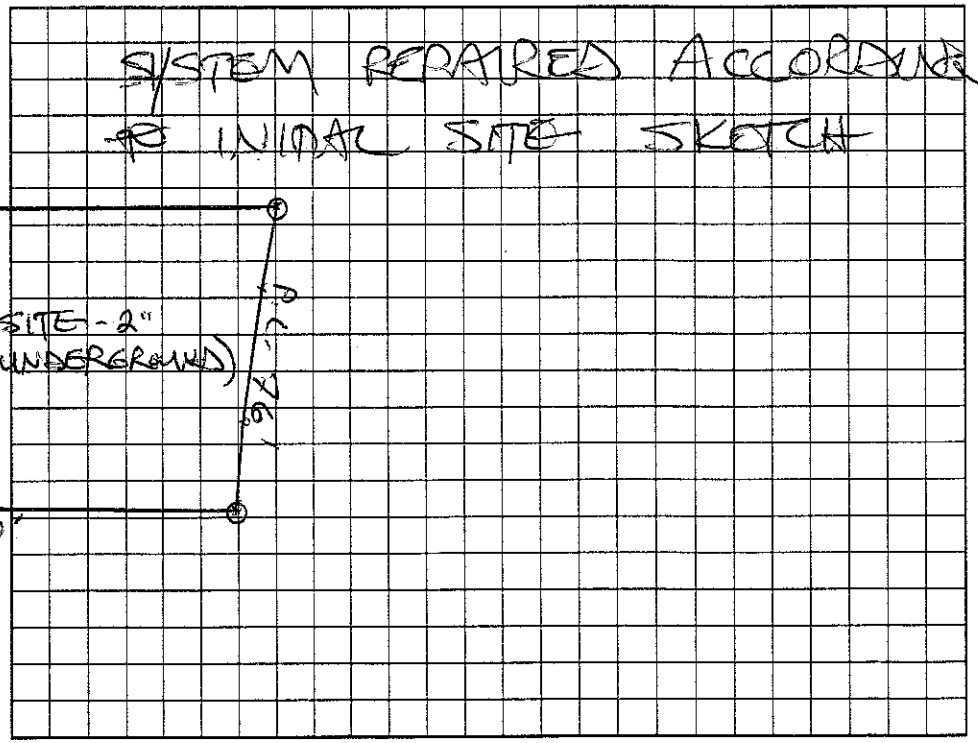

Permit can be suspended or revoked if any false information is supplied toward securing the permit/any unauthorized changes are made to the site/any unauthorized changes are made in the installation of the system. Improvement Permit with plat valid without expiration. Improvement Permit with site plan valid for sixty months. Authorization to Construct is valid for a period equal to that of Improvement Permit – not to exceed sixty months.

Signed: Quis N. Walsh date 4/23/03 Installed by: WES LYNTON

Improvement Permit by: STEVE HENDRICK date 4-23-03 Operation Permit by: STEVE HENDRICK date 6-11-03

Authorization to Construct by: STEVE HENDRICK date 4-23-03 Existing System Inspection by: date

HEALTH DEPT. COPY: WHITE OWNER COPY (FINAL): YELLOW OWNER COPY (INITIAL): PINK