IREDELL COUNTY HEALTH DEPARTMENT - *ENVIRONMENTAL HEALTH* ☐ STATESVILLE OFFICE 704-878-5305 ☐ MOORESVILLE OFFICE 704-664-5281

IMPROVEMENT PERMIT / AUTHORIZATION TO CONSTRUCT / OPERATION PERMIT / EXISTING SYSTEM INSPECTION

PERMIT # 168779 PIN # 4732-76-7467 DATE 3 October 2011

OWNER Garth Litaker APPLICANT: PHONE: Home/Cell # (704) 878-0851 Business #

SITE ADDRESS 177 Moose Club Rd. OWNER / APPLICANT ADDRESS

SITE DIRECTIONS Hwy 21 S Turn onto Moose Club Rd. TL beside Moose Club Rd. - on left.


SUBDIVISION BLOCK / SECTION LOT # LOT AREA 1.8 Ac. DESIGN FLOW 480 g/d L.T.A.R. 0.3/454 g/d

Septic Tank 1000	Gallons: STB 1160	Date 6/11	☐ New System ☑ Repair ☐ Expansion System Type I II (III) V V Vi	☑ Residence	No. Bedrooms 4	Water Supply ☑ Private
Pump Tank	Gallons: P T	Date	System Description:	☐ Business	No. Persons	☐ Public
Pump Make	Model	Serial #	Repair System Description: 25% Reduction Syst.	☐ Other	No. Employees	☐ Community
No. Nitrification Fields: 1	No. Lines 4	Linear Feet 400	Maintenance Agreement Required ☐ YES ☑ NO	☐ Slab	☐ Crawl Space	
Trench Width 36"	Max. Trench Bottom Depth 36"		Gravel Depth NA ☑ GRAVITY ☐ PRESSURE	☐ Basement w/plumbing	☑ Basement w/o plumbing	


Comments / Conditions Property Abandon old septic tank. Cut-off old system.

Septic tank has marker. Polylock Fittings.

INITIAL SITE SKETCH

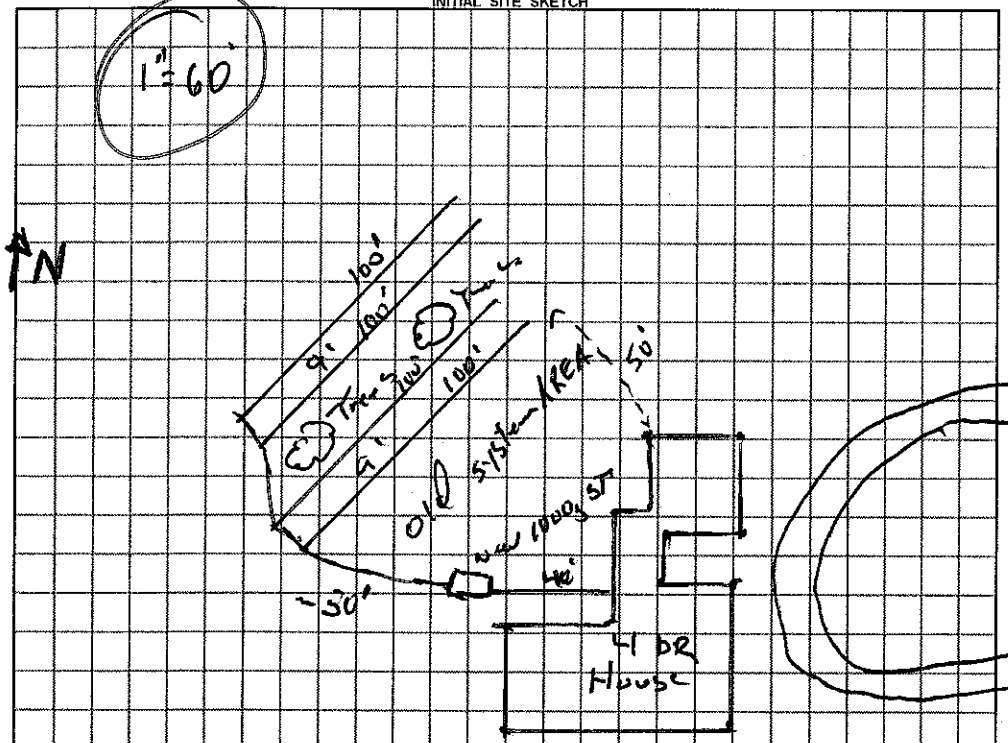

AS BUILT SKETCH

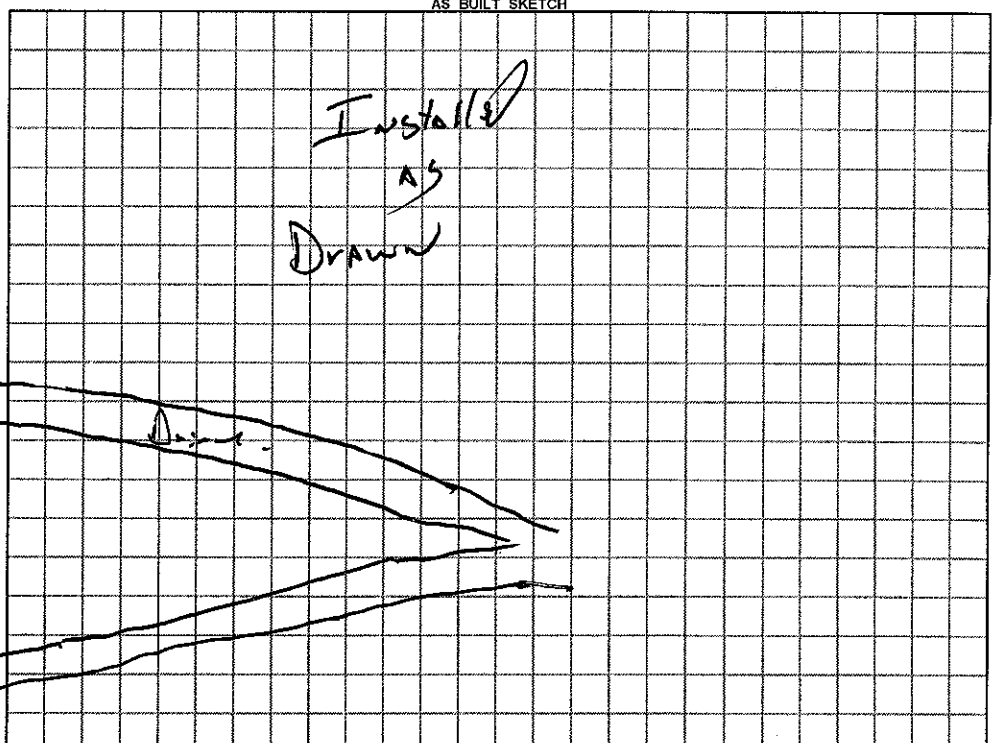

Permit can be suspended or revoked if any false information is supplied toward securing the permit / any unauthorized changes are made to the site / any unauthorized changes are made in the installation of the system.

☐ *IMPROVEMENT PERMIT* with plat valid without expiration. ☑ *IMPROVEMENT PERMIT* with plat site plan valid 60 mo. ☑ *AUTHORIZATION TO CONSTRUCT* valid for period equal to IMPROVEMENT PERMIT--not to exceed 60 mo.

Owner / Applicant Signature: Date 10-4-11 Installed by: Kevin Boles

IMPROVEMENT PERMIT by: REHS Date 3 Oct 11 OPERATION PERMIT by: REHS Date 6 October 11

AUTHORIZATION TO CONSTRUCT by: REHS Date 3 Oct 11 Existing System Inspected by: REHS Date

YOU SHOULD CONTACT A LOCATOR SERVICE PRIOR TO ANY EXCAVATION

White Copy – Environmental Health YELLOW COPY (Final) Owner / Applicant PINK COPY (Initial) Owner / Applicant