IREDELL COUNTY HEALTH DEPARTMENT

Statesville Office (704) 878-5305 Mooresville Office (704) 660-3625 PERMIT # 181530 BF

IMPROVEMENT PERMIT / AUTHORIZATION TO CONSTRUCT / OPERATION PERMIT / EXISTING SYSTEM

PIN # 4732789684

APPLICANT: Charles Haney APPLICANT ADDRESS: 191 Elysian Dr.

SITE ADDRESS: 136 Scenery Dr. PHONE: 301-268-2232 ALT. PHONE: N/A

SITE DIRECTIONS: Hwy 215 TL Cumberland TL Watertrough TR Scenery Dr.

SUBDIVISION: Sable Crossing SECTION: N/A LOT # 4 LOT AREA: 2.64 acres DESIGN FLOW: 360gpd L.T.A.R.: Existing


Septic Tank	Existing (gal)	STB	Date	☐ New System	☐ Repair	☐ Expansion	System Type: I (II) III IV V VI	☑ Residence	No. Bedrooms	3	Water Supply
Pump Tank	(gal)	PT	Date	System Description:	Conventional			☐ Business	No. Persons		☑ Private
Pump Make	Model		Serial #	Repair System Description:				☐ Other	No. Employees		☐ Public
# Nitrification Fields	Ex # Lines Ex		Linear Ft: Ex	Maintenance Agreement Required:	☐ YES	☑ NO		☐ Slab	☑ Crawl Space		☐ Community
Trench Width	Ex Max. Trench Bottom Depth Ex		Gravel Depth Ex	☑ GRAVITY	☐ PRESSURE			☐ Basement w/plumbing	☐ Basement w/o plumbing		

Comments / Conditions:

- Maintain a minimum of ~~5'~~ 5' between home foundation and all components of septic tank system.

INITIAL SITE SKETCH

AS BUILT SKETCH

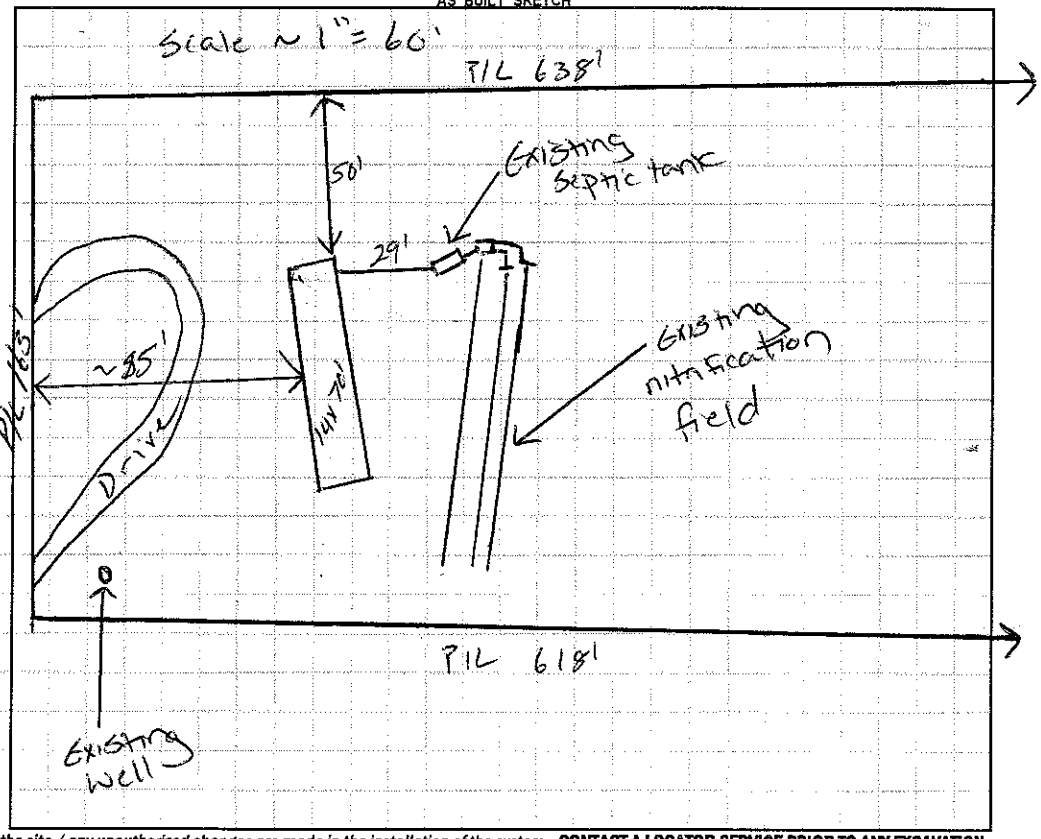

Permit can be suspended or revoked if any false information is supplied toward securing the permit / any unauthorized changes are made to the site / any unauthorized changes are made in the installation of the system. **CONTACT A LOCATOR SERVICE PRIOR TO ANY EXCAVATION**

☐ **IMPROVEMENT PERMIT** ***with plat*** *valid without expiration.* ☐ **IMPROVEMENT PERMIT** ***with site plan*** *valid for 60 mos.* ☐ **AUTHORIZATION TO CONSTRUCT** *valid for period equal to IMPROVEMENT PERMIT--not to exceed 60 mo.*

Owner / Applicant Signature: Charles Haney Date: 11-08-13 Installed by:

IMPROVEMENT PERMIT by: Date: OPERATION PERMIT by: Date:

AUTHORIZATION TO CONSTRUCT by: Date: Existing System Inspected by: Justin Anderson Date: 11-7-13

Health Dept. Copy - WHITE Applicant (Final Approval) - YELLOW Applicant (Conditional Approval) - PINK