IREDELL COUNTY HEALTH DEPARTMENT

Statesville Phone TR 3-7271 Mooresville Phone No. 664-5281

PERMIT TO INSTALL SEPTIC TANK

Permit No. _____ Permit Date 11-2 1972

Owner Mrs. Reid Brawley Address Statesville, N.C.

Installed By Henry Norman Address Statesville, NC


Location of Property Highway 21 S - Across From Iredell Memorial Cemetary

Tank		Capacity		Length of Lines		Fixtures	
Block	( )	1000	( )	225'	( )	No. of Baths	( ) 2
Precast	(✓)	1250	(✓)	250'	( )	Dishwasher	( )
		1500	( )	Other 400		Garbage Grdr.	( ),
		Other				Other	

NOTIFY HEALTH DEPARTMENT AT LEAST EIGHT HOURS BEFORE TANK IS TO BE INSPECTED.

Final Inspection 11-2 1972 Approved (✓) Disapprcved ( )

Remarks WATER Supply - City of Statesville

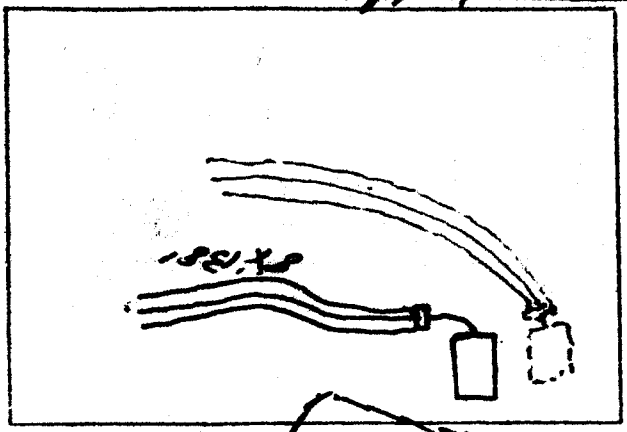

This system designed by Mr Johnson

Sketch of Installation Bldg

Sanitarian