IREDELL COUNTY HEALTH DEPARTMENT

Statesville Phone TR 3-7271 Mooresville Phone NO 3-1271

PERMIT TO INSTALL SEPTIC TANK

Permit No. 39 Permit Dat Oct 31 1972

Owner Dave K Crawley Address Rt 10 Statesville

Installed By _____ Address _____


Location of Property Trailer wind Shopping Center on Hwy 21

Tank		Capacity		Length of Lines		Fixtures	
Block	( )	1000	( )	225'	( )	No. of Baths	( )
Precast	( )	1250	(✓)	250'	( )	Dishwasher	( )
		1500	( )	Other 400'/Line		Garbage Grdr.	( )
		Other _____				Other _____	

NOTIFY HEALTH DEPARTMENT AT LEAST EIGHT HOURS BEFORE TANK IS TO BE INSPECTED.

Final Inspection Oct 31 1972 Approved (✓) Disapproved ( )

Remarks _____

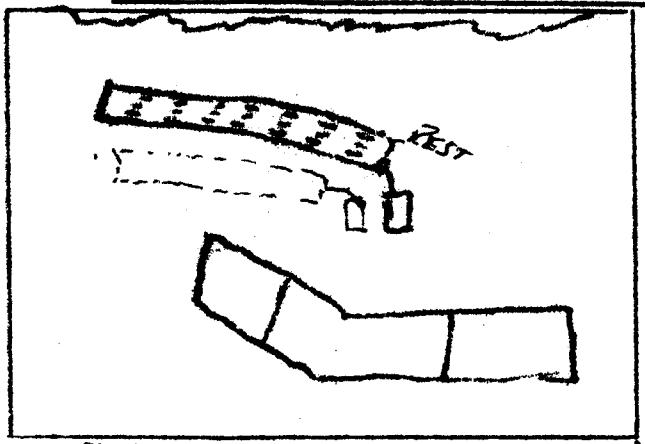

Sketch of Installation

R W Johnson Jr.
Sanitarian