IREDELL COUNTY HEALTH DEPARTMENT

STATESVILLE 704-878-5305 MOORESVILLE 704-664-5281

IMPROVEMENT PERMIT / AUTHORIZATION TO CONSTRUCT / OPERATION PERMIT / EXISTING SYSTEM INSPECTION

PERMIT# 73134 PIN# 4732794311 DATE 5-1-98

OWNER OR CONTRACTOR Ray Fish PHONE: Business _____ Home 872 5677

ADDRESS 125 Water Trough Rd Sta N.C.

LOCATION 115 S TL Cumberland TL Water Trough 2nd Drive TL at end

SUBDIVISION Sable Point BLOCK / SECTION _____ LOT 14 LOT AREA 2 acres SITE CLASS. PS DESIGN FLOW 240 L.T.A.R. .2

Septic Tank: 1000 Gallons; STB _____ Date _____

Pump Tank: _____ Gallons; PT _____ Date _____

Pump Make: _____ Model _____ Serial No. _____

Nitrification Field: No Fields 1 Square Feet 1200 Linear Feet 400

No Lines 3 Trench Width 36" Max Trench Bottom Depth 36" Gravel Depth 12"

☑ New System ☐ Repair System Type: I, II, III, IV, V, VI

System Description: Conv. Gravity

Repair System Description: " "

Maintenance Agreement Required: ☐ Yes ☑ No

☐ House/Mod. Home ☑ Mobile Home ☐ Business ☐ Other

No. Bedrooms 2 No. Bathrooms 2 No. Employees _____

☐ Slab ☑ Crawl Space ☐ Basement w/plumbing ☐ Basement wo/plumbing


Water Supply: ☑ Individual ☐ Public ☐ Community

Comments:/Conditions:


Comments:/Conditions:

95

INITIAL SITE SKETCH

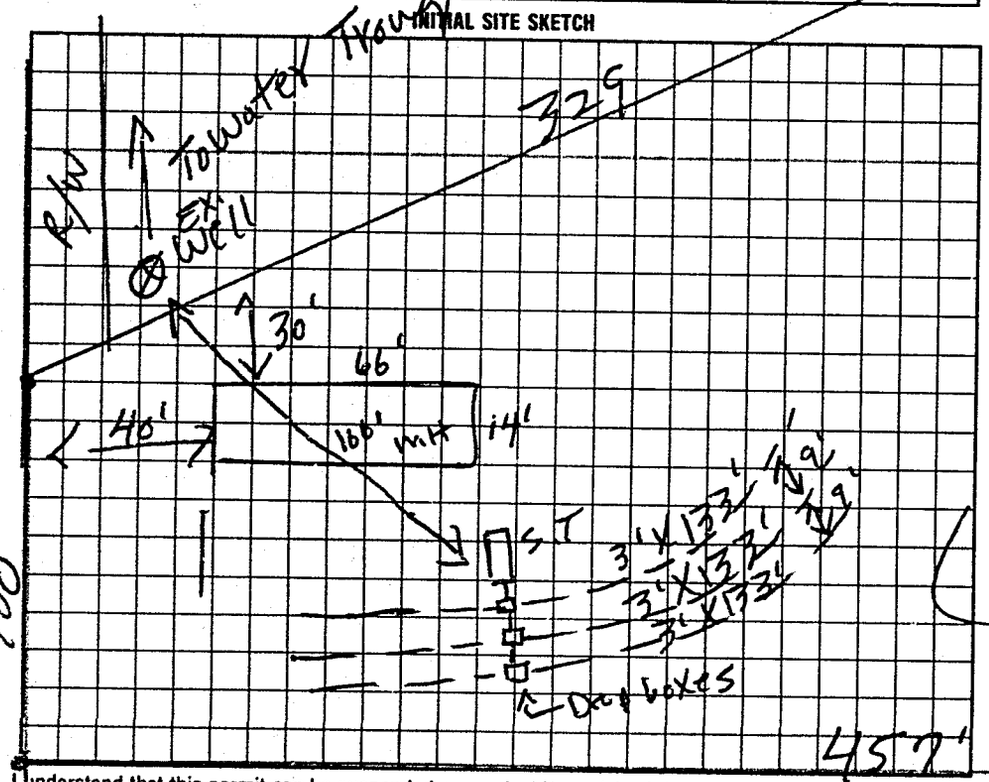

AS BUILT SKETCH

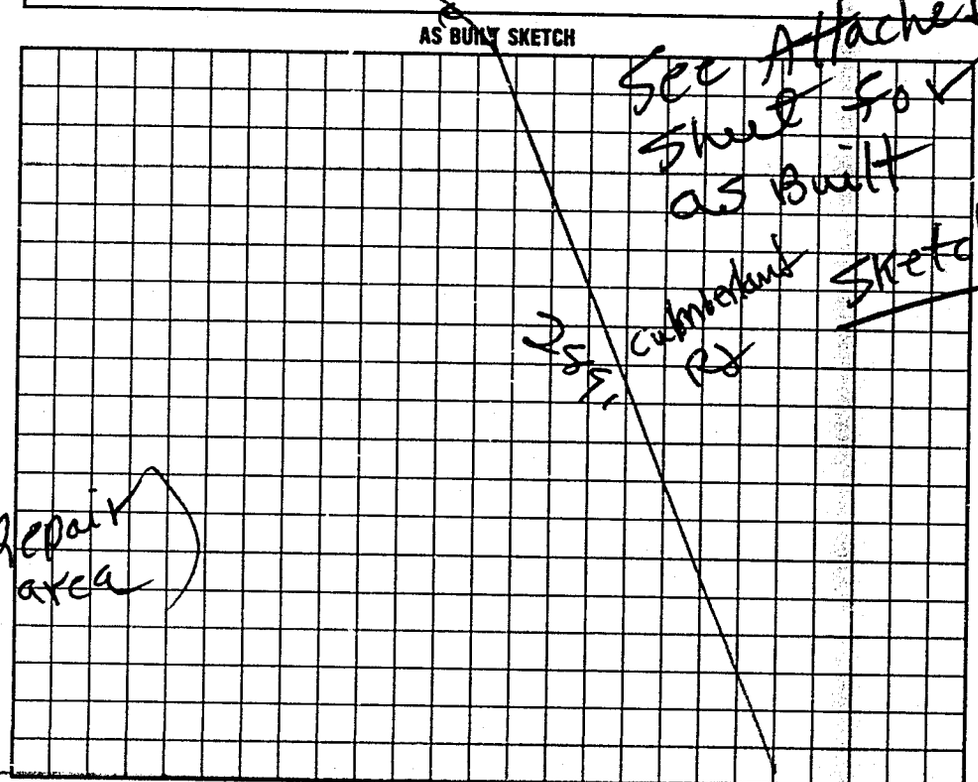

I understand that this permit can be suspended or revoked if any false information is supplied toward securing the permit/any unauthorized changes are made to the site/any unauthorized changes are made in the installation of the system. Improvement Permit with plat valid without expiration. Improvement Permit with site plan valid for sixty months. Authorization to Construct is valid for a period equal to that of Improvement Permit – not to exceed sixty months.

Signed: x Gail Moseley date 5-1-98 Installed by: A-1 Backhoe

Improvement Permit by: P.C. Moore date 5-1-98 Operation Permit by: P.C. Moore date 5-21-98

Authorization to Construct by: P.C. Moore date 5-1-98 Existing System Inspection by: _____ date _____

HEALTH DEPT COPY WHITE INSPECTION COPY (FINAL) GREEN OWNER COPY (FINAL) YELLOW INSPECTION COPY (INITIAL) PINK OWNER COPY (INITIAL) GOLD