IREDELL COUNTY HEALTH DEPARTMENT

STATESVILLE 704-878-5305 MOORESVILLE 704-664-5281

IMPROVEMENT PERMIT / AUTHORIZATION TO CONSTRUCT / OPERATION PERMIT / EXISTING SYSTEM INSPECTION

(C1)

PERMIT# 139813 PIN# 4732-79-4811

OWNER OR APPLICANT GARY & CHARLENE MILLER PHONE: Business 704-881-0214 Home

ADDRESS 123 FISH HILL DRIVE DATE 1-3-2007

LOCATION US 21 South, TL CUMBERLAND DR, TL WATERING TROUGH, TL FISH HILL, MH AT END

SUBDIVISION Sable point BLOCK / SECTION LOT 14 LOT AREA SITE CLASS. P2 DESIGN FLOW 360 L.T.A.R. EXISTING

Septic Tank: 1000 Gallons; STB Date

Pump Tank: Gallons; PT Date

Pump Make: Model Serial No.

Nitrification Field: No Fields 1 Square Feet Linear Feet EXISTING

No Lines Trench Width Max Trench Bottom Depth Gravel Depth

☐ New System ☐ Repair ☐ Expansion System Type: ☒ I ☐ II ☐ III ☐ IV ☐ V ☐ VI

System Description: CONVENTIONAL, GRAVITY

Repair System Description:

Maintenance Agreement Required: ☐ Yes ☒ No

☒ Gravity ☐ Pressure

☐ House/Mod. Home ☒ Mobile Home ☐ Business ☐ Other

No. Bedrooms 3 No. Persons No. Employees


☐ Slab ☒ Crawl Space ☐ Basement w/plumbing ☐ Basement wo/plumbing

Water Supply: ☒ Individual ☐ Public ☐ Community WELL


Comments:/Conditions:

Comments:/Conditions: MH ON SITE AT TIME of INSPECTION

INITIAL SITE SKETCH

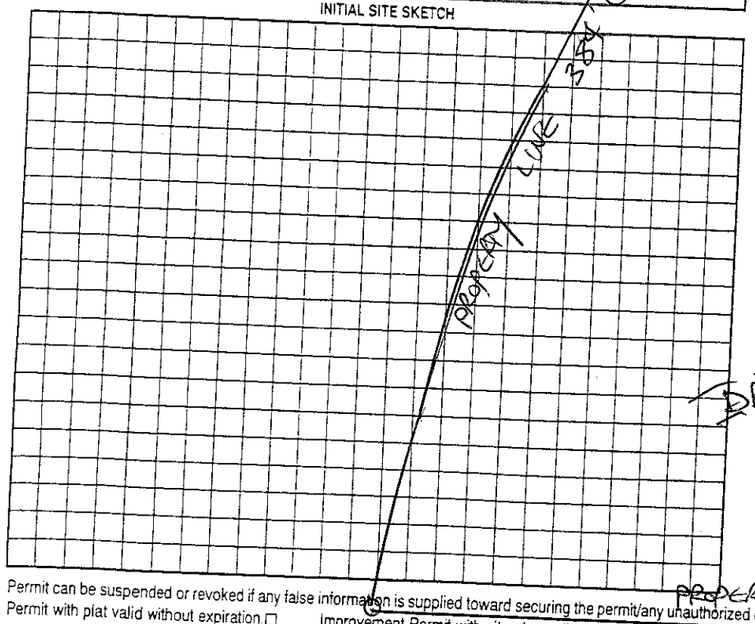

AS BUILT SKETCH

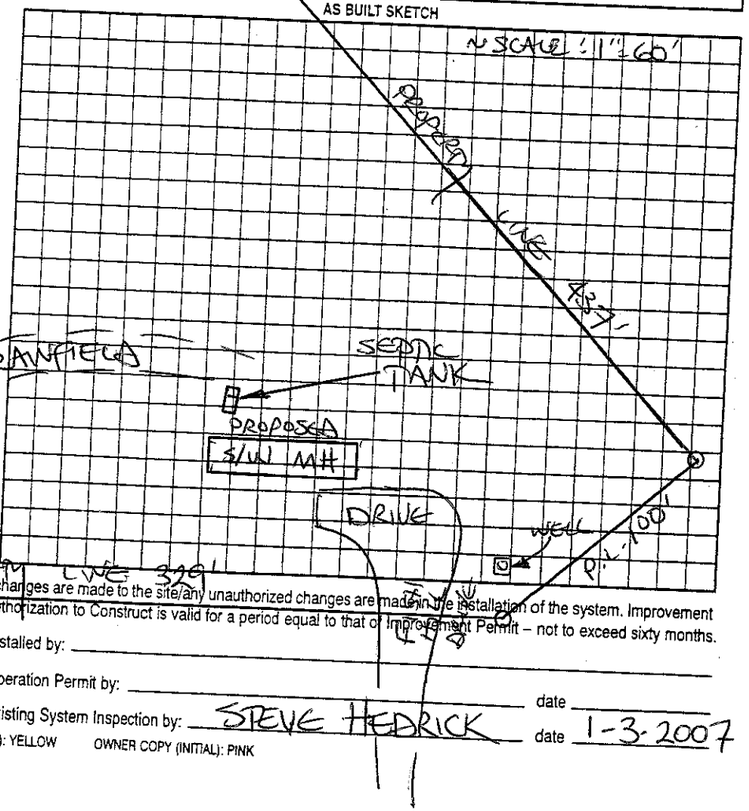

Permit can be suspended or revoked if any false information is supplied toward securing the permit/any unauthorized changes are made to the site/any unauthorized changes are made in the installation of the system. Improvement Permit with plat valid without expiration ☐ Improvement Permit with site plan valid for sixty months ☐ Authorization to Construct is valid for a period equal to that of Improvement Permit – not to exceed sixty months.

Signed: date

Improvement Permit by: date

Authorization to Construct by: date

Installed by:

Operation Permit by: date

Existing System Inspection by: STEVE HEDRICK date 1-3-2007

HEALTH DEPT. COPY: WHITE OWNER COPY (FINAL): YELLOW OWNER COPY (INITIAL): PINK