11:00

IREDELL COUNTY HEALTH DEPARTMENT

STATESVILLE 704-878-5305 MOORESVILLE 704-664-5281

IMPROVEMENT PERMIT / CERTIFICATE OF COMPLETION / OPERATION PERMIT / EXISTING SYSTEM INSPECTION

PROPERTY DESCRIPTION NO. _____ DATE 11-17-95 TAX MAP NO. _____ Watershed: ☐ Yes ☐ No

OWNER OR CONTRACTOR Robert Fesperman PHONE: Business _____ Home 528 9421

ADDRESS PO BOX 205 Bellevue Sp.

LOCATION 215 TL Moose Club TL Washboard NEXT cut on RT

SUBDIVISION _____ BLOCK / SECTION _____ LOT _____ LOT AREA 100'X200' SITE CLASS. _____ DESIGN FLOW 240 L.T.A.R. .3

Septic Tank: EX. Gallons; STB _____ Date _____

Pump Tank: _____ Gallons: PT _____ Date _____

Pump Make: _____ Model _____ Serial No. _____

Nitrification Field: No Fields 2 Square Feet 690 Linear Feet 230

No Lines 3 Trench Width 36" Max Trench Bottom Depth 36" Gravel Depth 12"

☐ New System ☐ Repair System Type: I, II, III, IV, V, VI

System Description: _____

Repair System Description: Valve to conv. lines

Maintenance Agreement Required: ☐ Yes ☐ No

☐ Slab ☐ Crawl Space ☐ Basement w/plumbing ☐ Basement wo/plumbing

☐ House/Mod. Home No. Bedrooms 2

☐ Mobile Home No. Bathrooms 2

☐ Business No. Employees _____


☐ Other _____

Water Supply: ☑ Individual ☐ Community ☐ Public


Comments: Install Bull Run valve & Run Solid line to Front yard

Comments: Connect washer to Septic Tank System

INITIAL SITE SKETCH

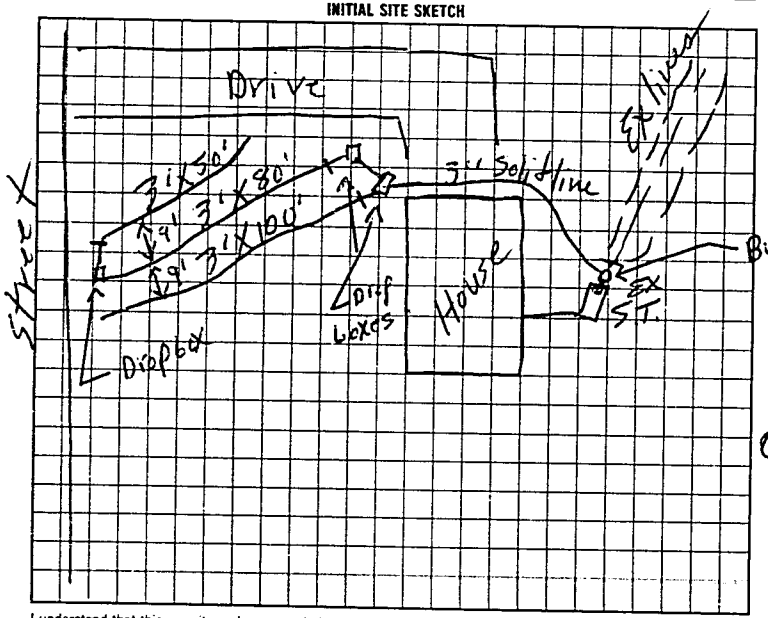

AS BUILT SKETCH

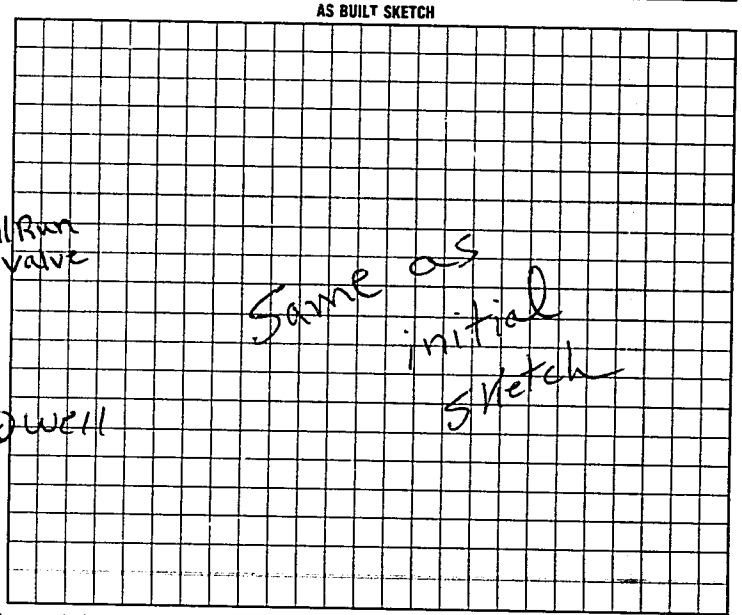

I understand that this permit can be suspended or revoked if any false information is supplied toward securing the permit/any unauthorized changes are made to the site/any unauthorized changes are made in the installation of the system.

Signed: X Patricia Fesperman

Improvement Permit by: L. C. Moore date 11-17-95

Existing System Inspection by: L. C. Moore date 11-17-95

Installed by: Escan Elder

Certificate of Completion by: _____ date _____

Operation Permit by: L. C. Moore date 11-27-95

Authorization to Const

PINK TO DEPT COPY WHITE — INSPECTION COPY (FINAL) GREEN — OWNER COPY (FINAL) YELLOW — INSPECTION COPY (INITIAL) PINK — OWNER COPY (INITIAL) GOLD

Expires 60 mos from date of issue