IREDELL COUNTY HEALTH DEPARTMENT

STATESVILLE 704-878-5305 MOORESVILLE 704-664-5281

IMPROVEMENT PERMIT / AUTHORIZATION TO CONSTRUCT / OPERATION PERMIT / EXISTING SYSTEM INSPECTION

PERMIT# 102917 PIN# 4732-88-1579 DATE 10-30-01

OWNER OR CONTRACTOR JERRY & BRENDA BARE PHONE: Business Home

ADDRESS 130 SCENERY DR. BARIUM SPRINGS, NC 28010

LOCATION 4521 SOUTH, TL CUMBERLAND ROAD, TL WATERING TROUGH ROAD, TR SCENERY DR, 2ND LOT ON RIGHT

SUBDIVISION BLOCK / SECTION LOT LOT AREA 2.78 ACRES SITE CLASS P3 DESIGN FLOW 240 I.T.A.R. EXISTING

Septic Tank: 1000 Gallons: STB Date

Pump Tank: Gallons: PT Date

Pump Make: Model Serial No.

Nitrification Field: No Fields 1 Square Feet Linear Feet EXISTING

No Lines Trench Width Max Trench Bottom Depth Gravel Depth

☐ New System ☐ Repair System Type: I (II) III IV V VI

System Description: CONVENTIONAL GRAVITY

Repair System Description:

Maintenance Agreement Required: ☐ Yes ☒ No

☐ Slab ☐ Crawl Space ☐ Basement w/plumbing ☐ Basement wo/plumbing

☐ House/Mod. Home No. Bedrooms 2

☐ ~~Mobile~~ Home No. Bathrooms 2

☐ Business No. Employees


☐ Other

Water Supply:
☐ ~~Individual~~
☐ Public
☐ Community
WELL


Comments/Conditions:

Comments/Conditions

INITIAL SITE SKETCH

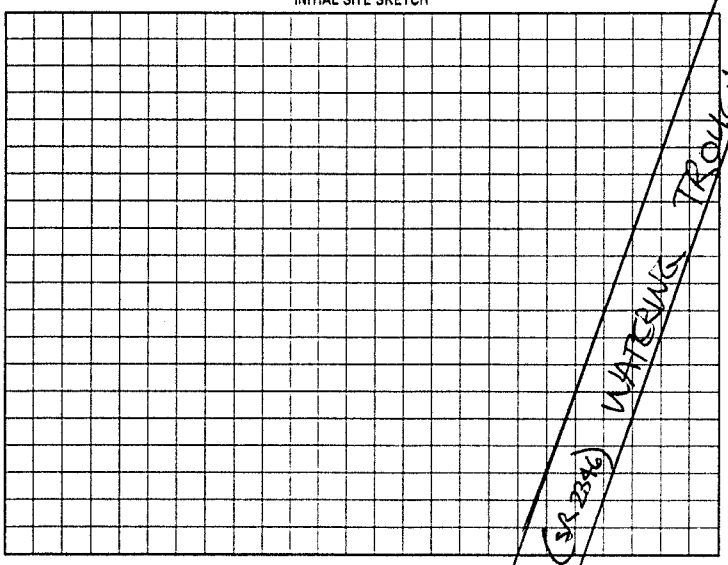

AS BUILT SKETCH

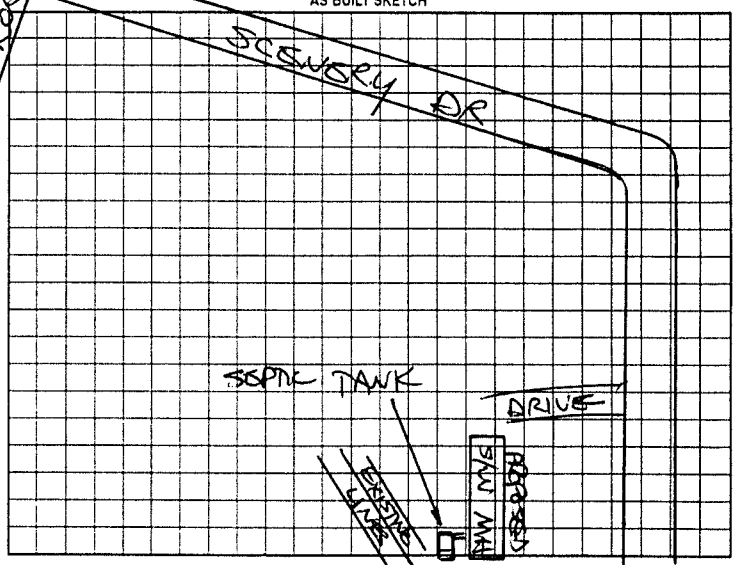

Permit can be suspended or revoked if any false information is supplied toward securing the permit; any unauthorized changes are made to the site; any unauthorized changes are made in the installation of the system. Improvement Permit with plat valid without expiration. Improvement Permit with site plan valid for sixty months. Authorization to Construct is valid for a period equal to that of Improvement Permit – not to exceed sixty months.

Signed: date

Improvement Permit by: date

Authorization to Construct by: date

Installed by:

Operation Permit by: date

Existing System Inspection by: STEVE HENDRICK date 10-30-01

HEALTH DEPT. COPY WHITE OWNER COPY (FINAL) YELLOW OWNER COPY (INITIAL) PINK