IREDELL COUNTY HEALTH DEPARTMENT

STATESVILLE 704-878-5305 MOORESVILLE 704-664-5281

IMPROVEMENT PERMIT / CERTIFICATE OF COMPLETION / OPERATION PERMIT / EXISTING SYSTEM INSPECTION

PROPERTY DESCRIPTION NO. 21375 DATE 6-26-95 TAX MAP NO. 6B-6-4-6 Watershed: ☐ Yes ☒ No

OWNER OR CONTRACTOR Robert B. Compton PHONE: Business Home 872-2957

ADDRESS 123 Rockwood Dr. Statesville

LOCATION US 21 S To Cumberland Rd To water Trough TR Scenery Dr. 2nd lot Rt

SUBDIVISION Sable Crossing BLOCK / SECTION LOT 6C LOT AREA 27686 sq' SITE CLASS. PS DESIGN FLOW 360 L.T.A.R. .3

Septic Tank: 1000 Gallons; STB 985920 Date 3/10/96

Pump Tank: Gallons; PT 1000gal Date

Pump Make: Model Serial No.

Nitrification Field: No Fields 1 Square Feet 1200 Linear Feet 400

No Lines 4 Trench Width 36" Max Trench Bottom Depth 36" Gravel Depth 12"

☒ New System ☐ Repair System Type: I, II, III, IV, V, VI

System Description: Conv. Gravity

Repair System Description:

Maintenance Agreement Required: ☐ Yes ☒ No

☐ House/Mod. Home No. Bedrooms 3

☒ Mobile Home No. Bathrooms 2

☐ Business No. Employees

☐ Other


☐ Slab ☒ Crawl Space ☐ Basement w/plumbing ☐ Basement wo/plumbing

Water Supply: ☒ Individual ☐ Community ☐ Public


Comments:

Comments: Keep MH 5' From Tank, Septic Lines

INITIAL SITE SKETCH

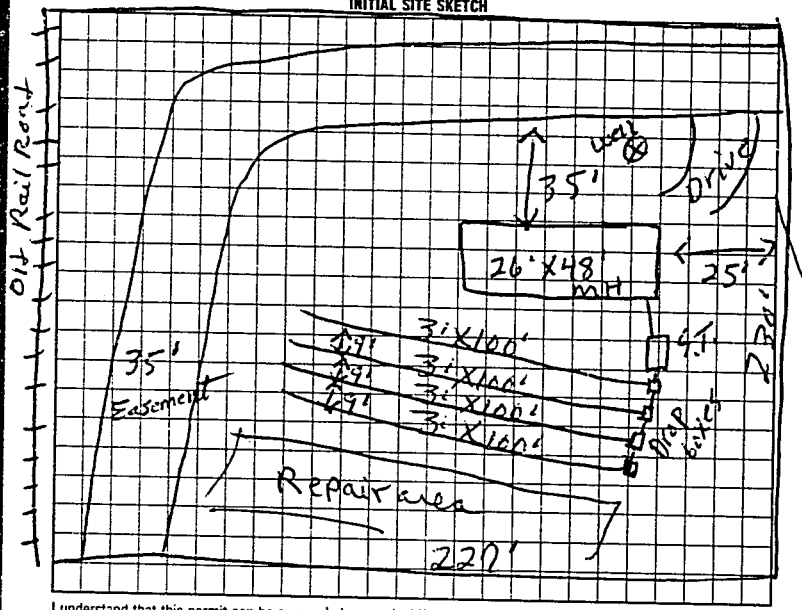

AS BUILT SKETCH

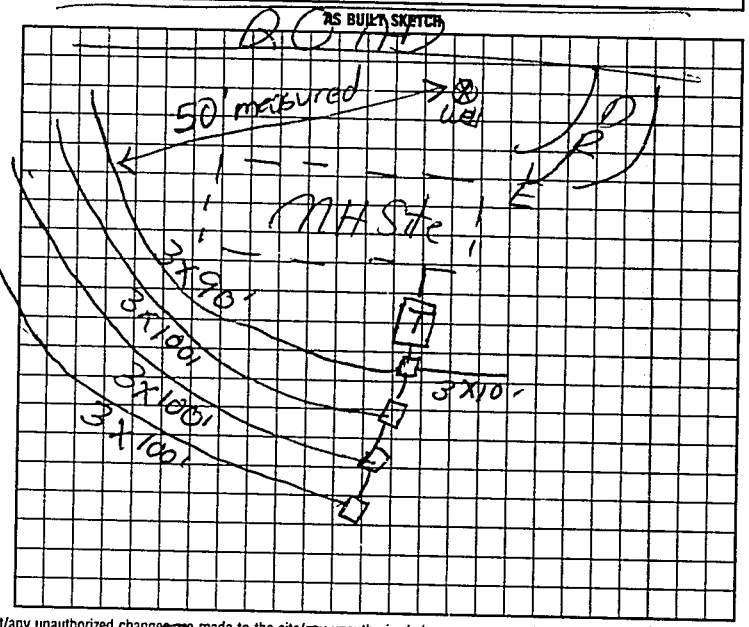

- I understand that this permit can be suspended or revoked if any false information is supplied toward securing the permit/any unauthorized changes are made to the site/any unauthorized changes are made in the installation of the system. Improvement Permit is valid for 60 months from date of issuance.

Signed: Robert B. Compton

Improvement Permit by: R. C. Moore date

Existing System Inspection by: date

Installed by: Sammy Reavis

Certificate of Completion by: date

Operation Permit by: date 9/3/96

HEALTH DEPT COPY: WHITE INSPECTION COPY (FINAL): GREEN OWNER COPY (FINAL): YELLOW INSPECTION COPY (INITIAL): PINK OWNER COPY (INITIAL): GOLD

2862