IREDELL COUNTY HEALTH DEPARTMENT

STATESVILLE 704-878-5305 MOORESVILLE 704-664-5281

IMPROVEMENT PERMIT / CERTIFICATE OF COMPLETION / OPERATION PERMIT / EXISTING SYSTEM INSPECTION

PROPERTY DESCRIPTION NO. 21272 DATE 6-7-95 TAX MAP NO. 6B-6-B- Ptof 6 Watershed: ☐ Yes ☒ No

OWNER OR CONTRACTOR Robert B. Compton PHONE: Business _____ Home 872-2954

ADDRESS 123 Rockweed Ln Statesville

LOCATION 21 S Th Cumberland Rd Th water Trough before old RR on Rt

SUBDIVISION Sable Crossing BLOCK / SECTION _____ LOT 6A LOT AREA 37686 SITE CLASS PS DESIGN FLOW 360 L.T.A.R. .3

Septic Tank: 1000 Gallons; STB 794 Date 9-11-00
Pump Tank: _____ Gallons; PT _____ Date _____
Pump Make: _____ Model _____ Serial No. _____
Nitrification Field: No Fields 1 Square Feet 1200 Linear Feet 400
No Lines 5 Trench Width 36" Max Trench Bottom Depth 36" Gravel Depth 12"

☐ New System ☐ Repair System Type: I ☒ II, IV, V, VI
System Description: Conv. Gravity
Repair System Description: Pump To Conv Lines
Maintenance Agreement Required: ☐ Yes ☐ No


☐ House/Mod. Home No. Bedrooms 3
☒ Mobile Home No. Bathrooms 2
☐ Business No. Employees _____
☐ Other _____
☐ Slab ☒ Crawl Space ☐ Basement w/plumbing ☐ Basement wo/plumbing

Water Supply: ☒ Individual ☐ Community ☐ Public


Comments:

Comments: Neighbor well 50ft And up grade from end of 1st Line #.1950 (b)
Lines deeper than 36" due To owner Relocating Drive

INITIAL SITE SKETCH

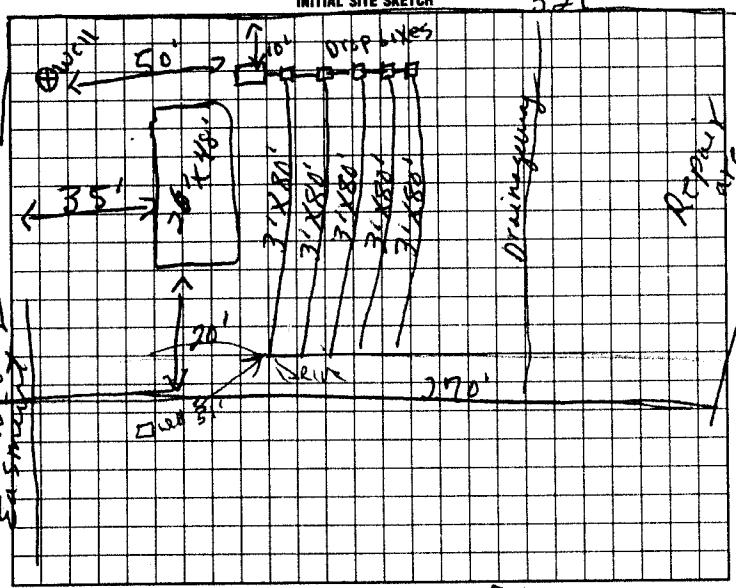

AS BUILT SKETCH

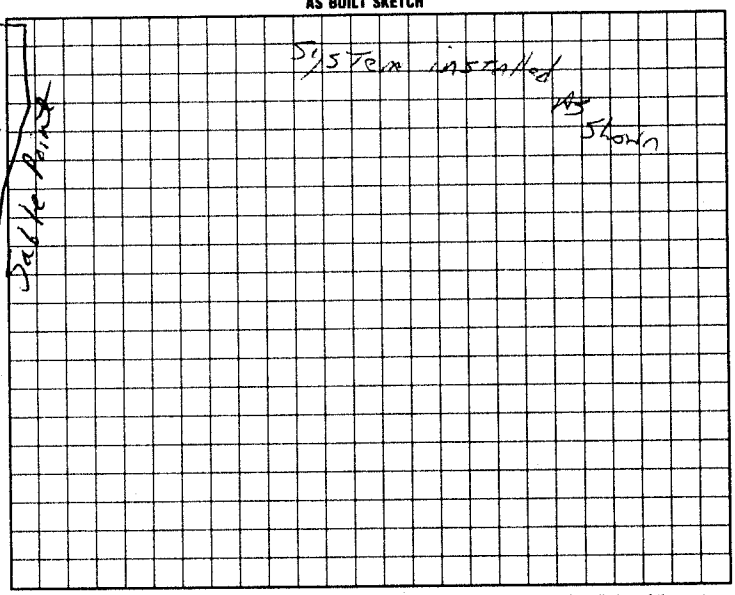

I understand that this permit can be suspended or revoked if any false information is supplied toward securing the permit/any unauthorized changes are made to the site/any unauthorized changes are made in the installation of the system. Improvement Permit is valid for 60 months from date of issuance.

Signed: Robert B. Compton

Improvement Permit by: P. C. Moore date 6-7-95

Existing System Inspection by: _____ date _____

Installed by: Marty Tucker

Certificate of Completion by: _____ date June 22 2000

Operation Permit by: _____ date _____

HEALTH DEPT. COPY: WHITE INSPECTION COPY (FINAL): GREEN OWNER COPY (FINAL): YELLOW INSPECTION COPY (INITIAL): PINK OWNER COPY (INITIAL): GOLD