IREDELL COUNTY HEALTH DEPARTMENT

STATESVILLE 704-878-5305 (C1) MOORESVILLE 704-664-5281

IMPROVEMENT PERMIT / AUTHORIZATION TO CONSTRUCT / OPERATION PERMIT / EXISTING SYSTEM INSPECTION

PERMIT# 123342 PIN# 4732-88-3997 DATE 8-19-04

OWNER OR CONTRACTOR ROBERT BEDORE PHONE: Business 704-528-7122 Home 704-871-2220

ADDRESS 161 WATERING TROUGH ROAD, STATESVILLE, NC 28677

LOCATION US 21 SOUTH, TL CUMBERLAND ROAD, TL WATERING TROUGH ROAD, 0.2 MILE ON LEFT AT #161

SUBDIVISION SABLE POINT BLOCK / SECTION ____ LOT 3 LOT AREA 0.64 ACRES SITE CLASS. PS1 DESIGN FLOW 480 L.T.A.R. 0.30 GPD/FT²

Septic Tank: EXISTING Gallons: ____ STB ____ Date ____

Pump Tank: ____ Gallons: ____ PT ____ Date ____

Pump Make: ____ Model ____ Serial No. ____

Nitrification Field: No Fields 1 Square Feet 720 Linear Feet 180

No Lines THREE Trench Width 36" Max Trench Bottom Depth 36" Gravel Depth ~~24~~"

☑ New System ☐ Repair System Type: I, II, III, IV, V, VI

System Description: 35% REDUCTION, GRAVITY

Repair System Description: 50% REDUCTION, LOW PRESSURE

Maintenance Agreement Required: ☐ Yes ☑ No

☐ House/Mod. Home ☑ Mobile Home ☐ Business ☐ Other

No. Bedrooms 4 No. Bathrooms ____ No. Employees ____

☐ Slab ☑ Crawl Space ☐ Basement w/plumbing ☐ Basement wo/plumbing


Water Supply: ☑ Individual ☐ Public ☐ Community WELL

Comments:/Conditions: EXPAND EXISTING SYSTEM BY INSTALLING NEW DISTRIBUTION BOX FEEDING OLD LINES FIRST, THEN FEEDING TWO NEW DROP BOXES FOR SERIAL DISTRIBUTION INTO 35% REDUCTION SYSTEM USING [redacted]


N/A

Comments:/Conditions: SYSTEM EXPANDED USING 18 EEE-22² FLOW SECTIONS

INITIAL SITE SKETCH 18 EEE-22² FLOW SECTIONS

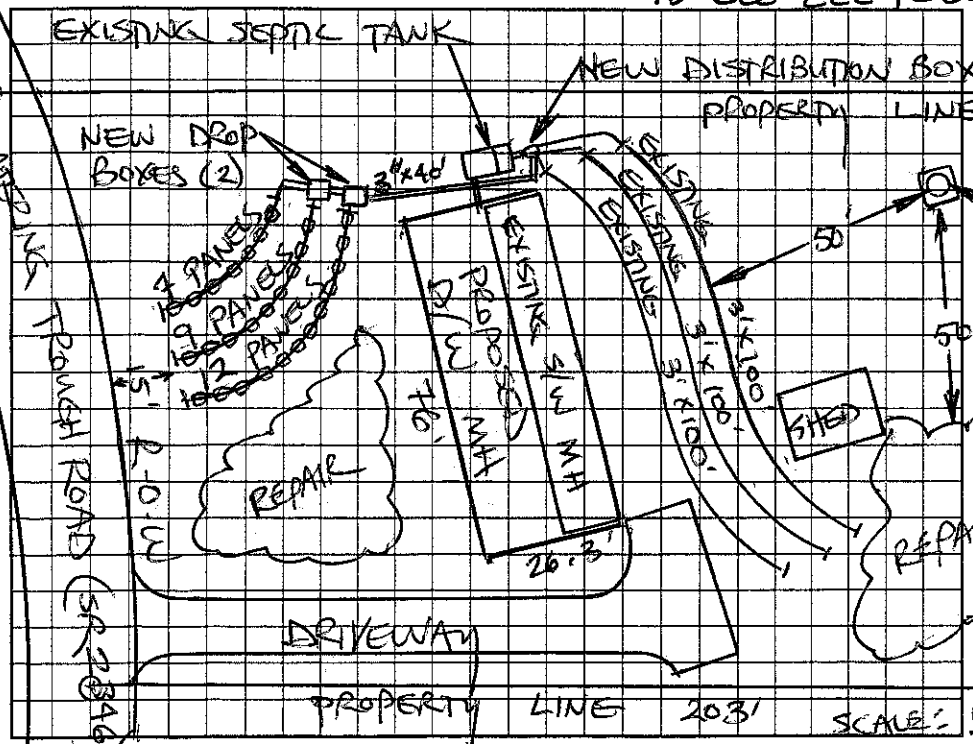

AS BUILT SKETCH

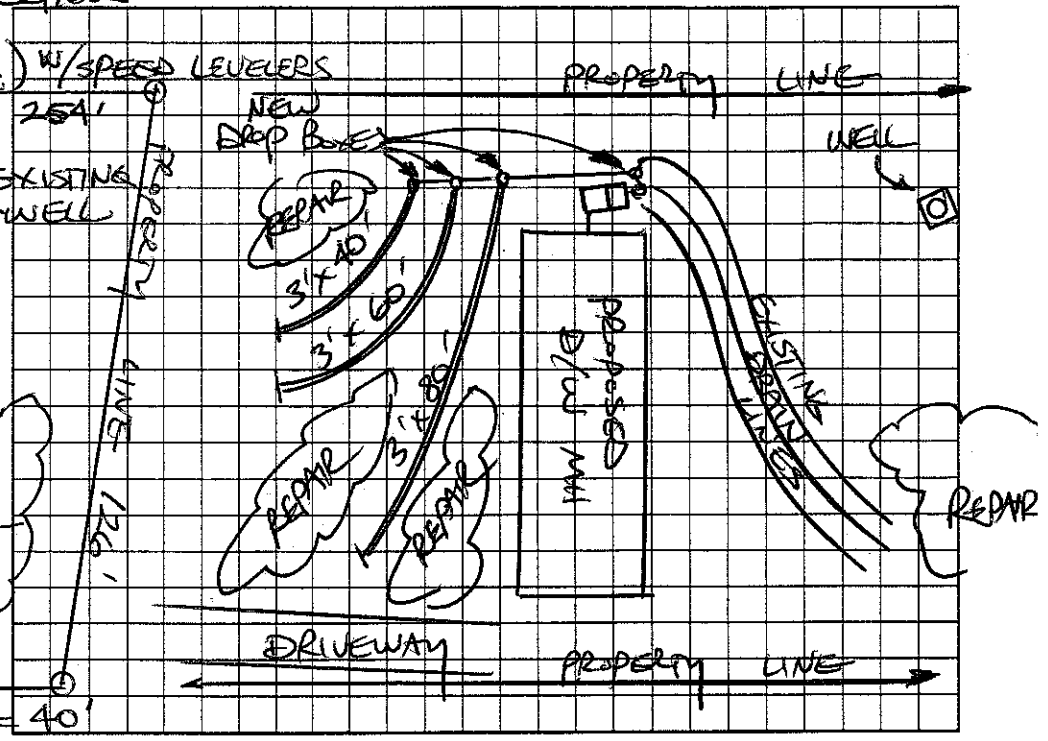

Permit can be suspended or revoked if any false information is supplied toward securing the permit/any unauthorized changes are made to the site/any unauthorized changes are made in the installation of the system. Improvement Permit with plat valid without expiration. Improvement Permit with site plan valid for sixty months. Authorization to Construct is valid for a period equal to that of Improvement Permit – not to exceed sixty months.

Signed: [signature] date 8/27/04 Installed by: A-1 BACKHOE

Improvement Permit by: STEVE HEDRICK date 8-19-04 Operation Permit by: STEVE HEDRICK date 9-30-04

Authorization to Construct by: STEVE HEDRICK date 8-19-04 Existing System Inspection by: ____ date ____

HEALTH DEPT. COPY: WHITE OWNER COPY (FINAL): YELLOW OWNER COPY (INITIAL): PINK