IREDELL COUNTY HEALTH DEPARTMENT

STATESVILLE 704-878-5305 MOORESVILLE 704-664-5281

IMPROVEMENT PERMIT / AUTHORIZATION TO CONSTRUCT / OPERATION PERMIT / EXISTING SYSTEM INSPECTION

PERMIT# 101588 PIN# 4732 88 4876 DATE 8/8/01

OWNER OR CONTRACTOR Oakwood Homes / Larry Petty PHONE: Business 528-4516 Home

ADDRESS 1092 Charlotte Hwy Troutman NC 28166

LOCATION 215, TL Moose Club, TL Skyuka, TL Watering Trough, on Rt.

SUBDIVISION Sable Pt. BLOCK / SECTION LOT 2 LOT AREA SITE CLASS PS DESIGN FLOW 360 L.T.A.R. 0.35

Septic Tank: 1000 Gallons: STB 794 Date 7-6-01
Pump Tank: Gallons: PT Date
Pump Make: Model Serial No.
Nitrification Field: No Fields 1 Square Feet 1028 Linear Feet 343
No Lines 3@14' Trench Width 36" Max Trench Bottom Depth 36"

☒ New System ☐ Repair System Type: I (II) III. IV. V. VI
System Description: Gravity Conventional
Repair System Description: Gravity Innovative
Maintenance Agreement Required: ☐ Yes ☒ No
Gravel Depth 12" ☐ Slab ☒ Crawl Space ☐ Basement w/plumbing ☐ Basement wo/plumbing


☐ House/Mod. Home No. Bedrooms 3
☒ Mobile Home No. Bathrooms 2
☐ Business No. Employees
☐ Other

Water Supply: ☒ Individual ☐ Public ☐ Community Shared well

Comments:/Conditions:
Ⓓ Potential Well Site

Comments./Conditions: ZABEL FILTER & MARKER INSTALLED AS SHOWN

INITIAL SITE SKETCH

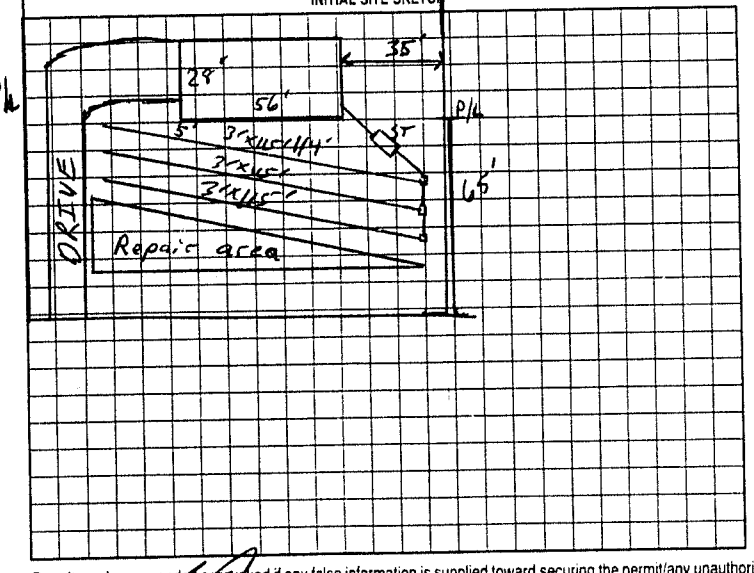

AS BUILT SKETCH

Permit can be suspended or revoked if any false information is supplied toward securing the permit/any unauthorized changes are made to the site/any unauthorized changes are made in the installation of the system. Improvement Permit with plat valid without expiration. Improvement Permit with site plan valid for sixty months. Authorization to Construct is valid for a period equal to that of Improvement Permit – not to exceed sixty months.

Signed: date 8-14-01
Improvement Permit by: RSI date 8/8/01
Authorization to Construct by: RSI date 8/8/01

Installed by: TOMMY HOYE & CHAS THOMPSON
Operation Permit by: KS date 8-17-01
Existing System Inspection by: date

HEALTH DEPT COPY WHITE OWNER COPY (FINAL) YELLOW OWNER COPY (INITIAL): PINK