IREDELL COUNTY HEALTH DEPARTMENT

STATESVILLE 704-878-5305 MOORESVILLE 704-664-5281

IMPROVEMENT PERMIT / AUTHORIZATION TO CONSTRUCT / OPERATION PERMIT / EXISTING SYSTEM INSPECTION

PERMIT# REPAIR PIN# 4732-89-1078 DATE 7-12-04

OWNER OR CONTRACTOR AUDREY P. BROWN PHONE: Business 704-996-7914 Home 704-892-3385

ADDRESS 445 MIDWAY LAKE ROAD, MOORESVILLE, NC 28166

LOCATION US 21 SOUTH, TL CUMBERLAND ROAD, TL WATERING TROUGH ROAD, ON LEFT AT #151

SUBDIVISION SABLE POINT BLOCK / SECTION ____ LOT 5 LOT AREA 0.8447 ACRE SITE CLASS. PS DESIGN FLOW 240/300 L.T.A.R. 0.30 GPD/FT2

Septic Tank: EXISTING Gallons; STB ____ Date ____

Pump Tank: ____ Gallons; PT ____ Date ____

Pump Make: ____ Model ____ Serial No. ____

Nitrification Field: No Fields 1 Square Feet 360 Linear Feet 120

No Lines TWO Trench Width 36" Max Trench Bottom Depth 36" Gravel Depth 18"

☐ New System ☑ Repair System Type: I (II) III, IV, V, VI

System Description: CONVENTIONAL GRAVITY

Repair System Description: CONVENTIONAL GRAVITY

Maintenance Agreement Required: ☐ Yes ☑ No

☐ House/Mod. Home No. Bedrooms 2

☑ Mobile Home No. Bathrooms 2

☐ Business No. Employees ____

☐ Other 5 PERSONS


☐ Slab ☐ Crawl Space ☐ Basement w/plumbing ☐ Basement wo/plumbing

Water Supply: ☑ Individual ☐ Public ☐ Community WELL


Comments:/Conditions: (1) INSTALL NEW DROP BOXES (3) AT LOCATIONS SHOWN FEEDING TWO NEW 3'X 60' LINES USING 18" STONE (2) THIS PERMIT SERVES AS "NOTICE OF VIOLATION," SYSTEM TO BE REPAIRED BY AUG, 12, 2004

Comments:/Conditions:

INITIAL SITE SKETCH

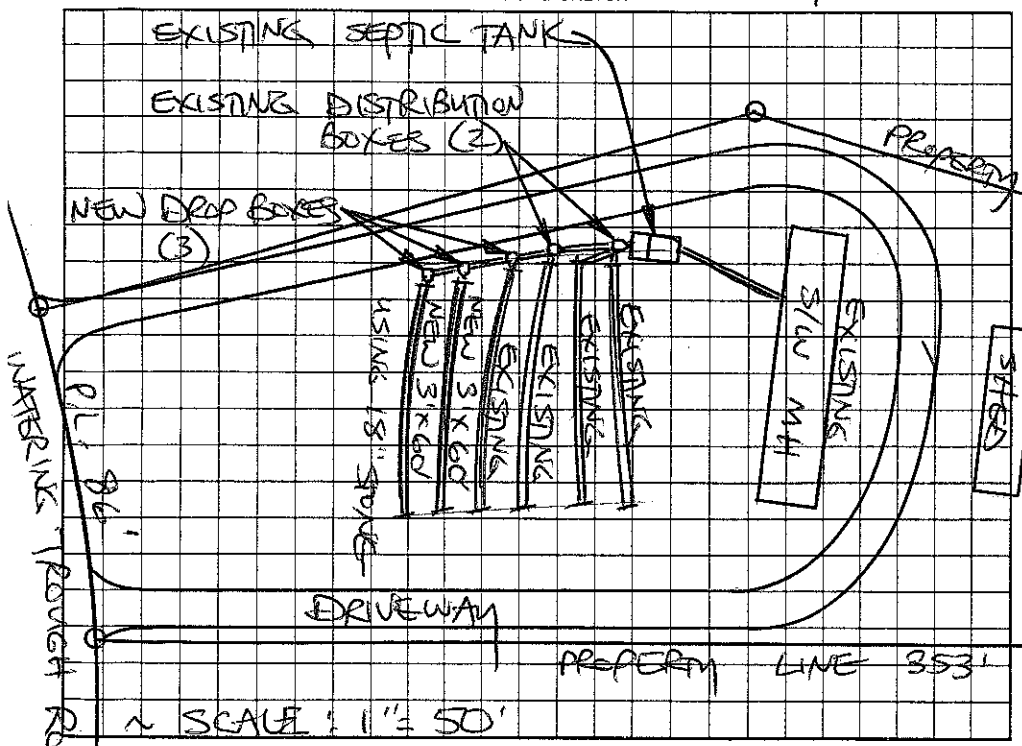

AS BUILT SKETCH

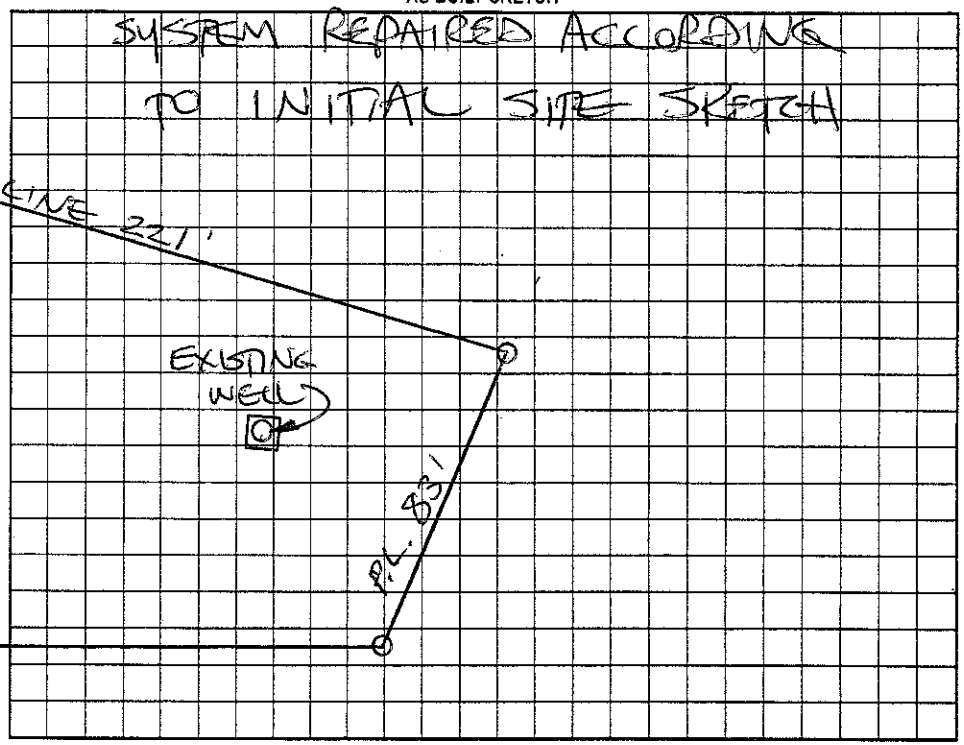

Permit can be suspended or revoked if any false information is supplied toward securing the permit/any unauthorized changes are made to the site/any unauthorized changes are made in the installation of the system. Improvement Permit with plat valid without expiration. Improvement Permit with site plan valid for sixty months. Authorization to Construct is valid for a period equal to that of Improvement Permit – not to exceed sixty months.

Signed: + Audrey P Brown date 7-12-04

Improvement Permit by: STEVE HEDRICK date 7-12-04

Authorization to Construct by: STEVE HEDRICK date 7-12-04

Installed by: PIEDMONT BACKHOE

Operation Permit by: STEVE HEDRICK date 7-16-04

Existing System Inspection by: ____ date ____

HEALTH DEPT. COPY: WHITE OWNER COPY (FINAL): YELLOW OWNER COPY (INITIAL): PINK