IREDELL COUNTY HEALTH DEPARTMENT

STATESVILLE 704-878-5305 MOORESVILLE 704-664-5281

IMPROVEMENT PERMIT / CERTIFICATE OF COMPLETION / OPERATION PERMIT / EXISTING SYSTEM INSPECTION

PROPERTY DESCRIPTION NO. 67213 DATE 6-24-97 TAX MAP NO. 4732-69-1621

OWNER OR CONTRACTOR Earlie C. Hager Watershed: ☐ Yes ☒ No

ADDRESS 524 Cove Gap Road PHONE: Business ____ Home 876-3154

LOCATION 21 South TL Cumberland TL Bluebird TR Chalet Estates at end

SUBDIVISION Chalet Est. BLOCK / SECTION ____ LOT 9 LOT AREA 1.2 acres SITE CLASS. PS DESIGN FLOW 240 L.T.A.R. .3

Septic Tank: 1000 Gallons; STB ? Date 8-10-98

Pump Tank: ____ Gallons; PT ____ Date ____

Pump Make: ____ Model ____ Serial No. ____

Nitrification Field: No Fields 1 Square Feet 810 Linear Feet 270

No Lines 3 Trench Width 36" Max Trench Bottom Depth 36" Gravel Depth 12"

☒ New System ☐ Repair System Type: I, (II), III, IV, V, VI

System Description: Conv. Gravity

Repair System Description: " "

Maintenance Agreement Required: ☐ Yes ☒ No

☐ House/Mod. Home ☒ Mobile Home ☐ Business ☐ Other ____

No. Bedrooms 2 No. Bathrooms 2 No. Employees ____

Water Supply: ☒ Individual ☐ Community ☐ Public


☐ Slab ☒ Crawl Space ☐ Basement w/plumbing ☐ Basement wo/plumbing

Comments: Gainwell

Comments:

INITIAL SITE SKETCH

AS BUILT SKETCH

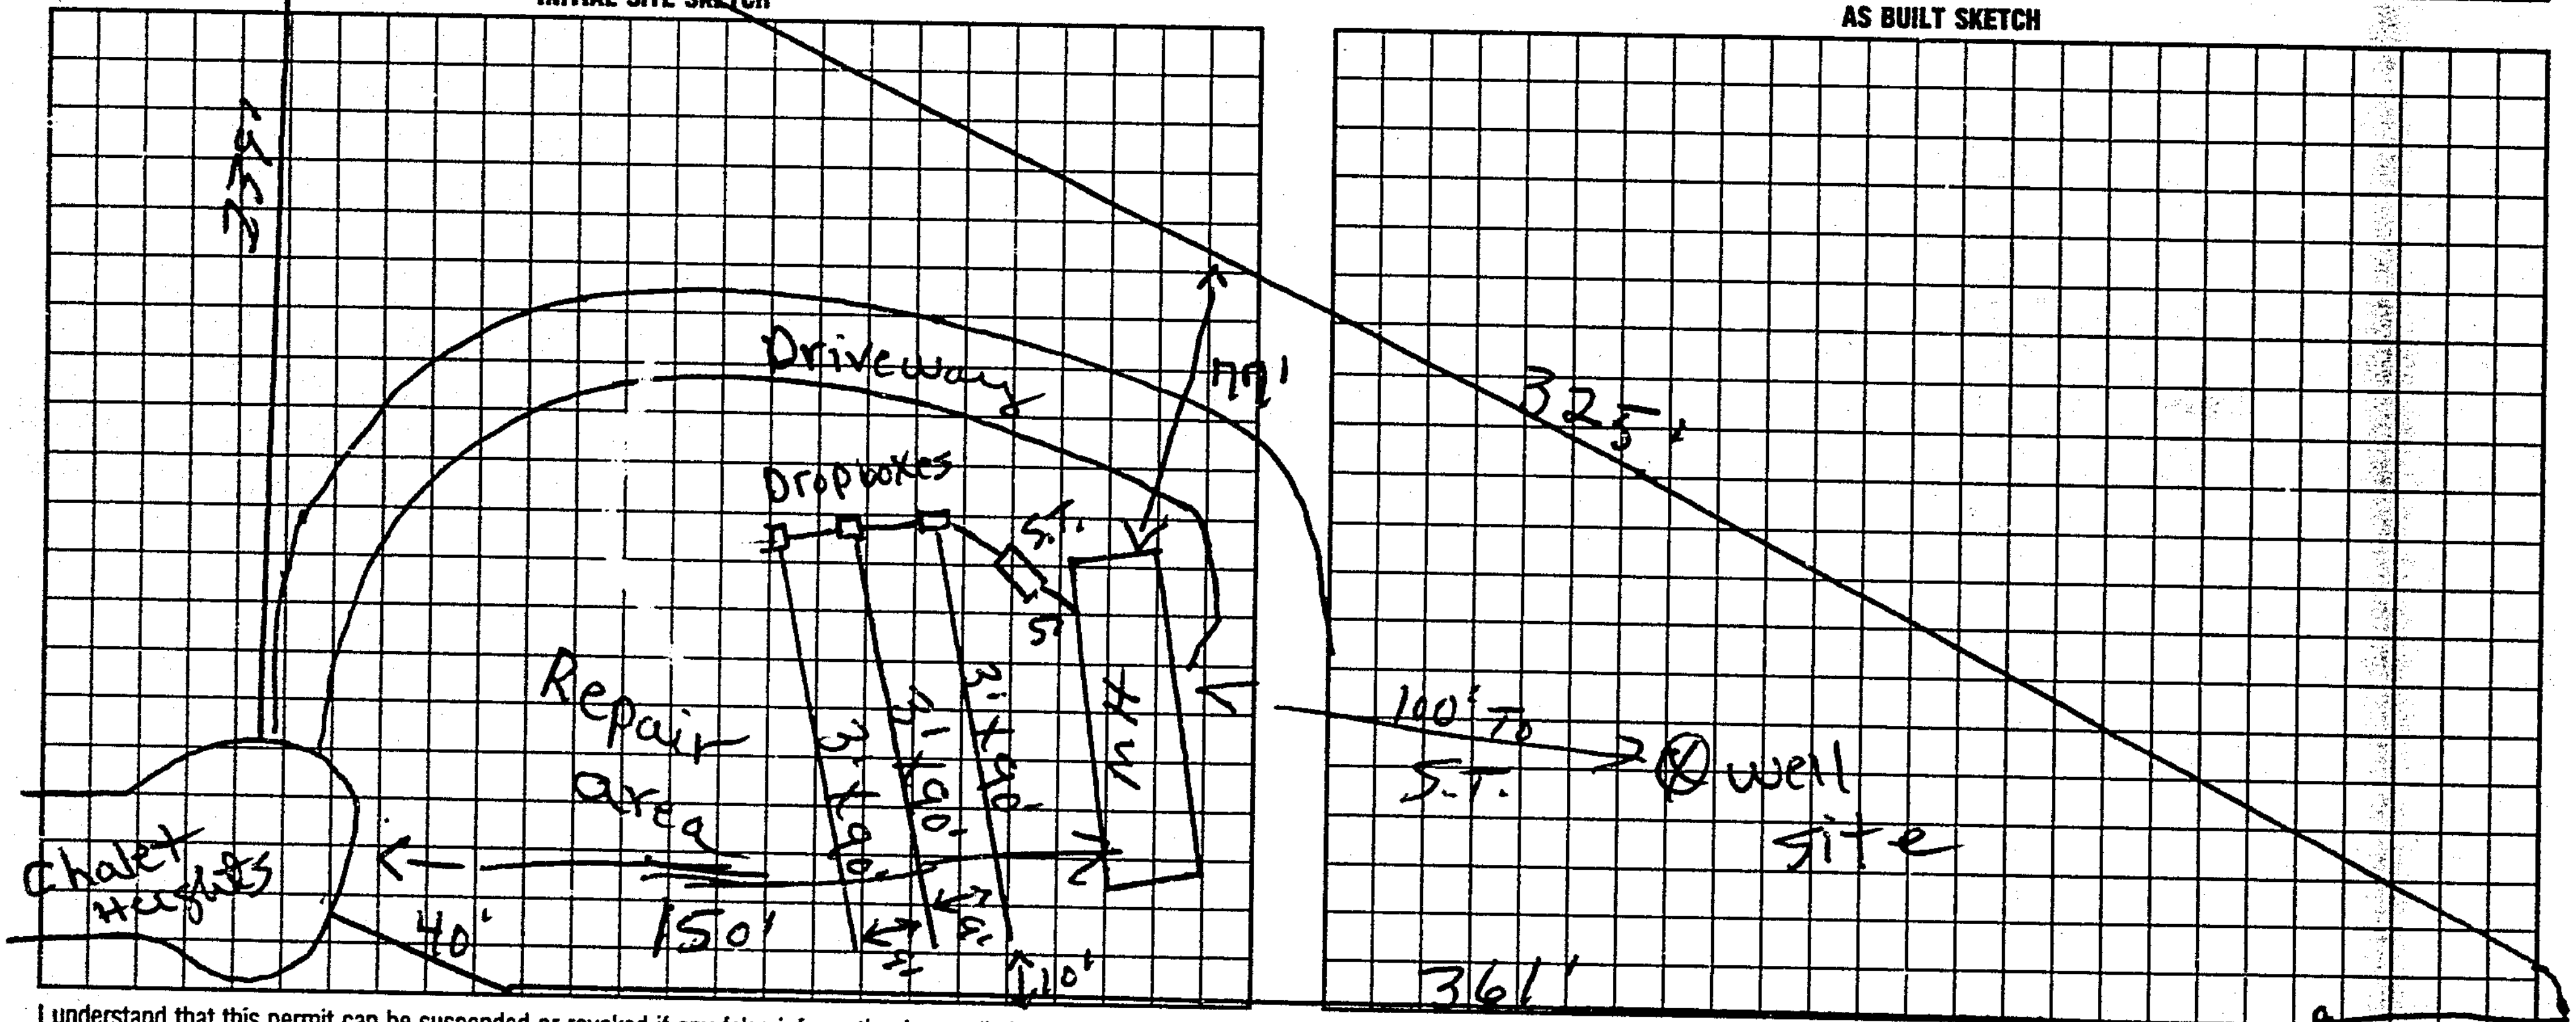

I understand that this permit can be suspended or revoked if any false information is supplied toward securing the permit/any unauthorized changes are made to the site/any unauthorized changes are made in the installation of the system. Improvement Permit is valid for 60 months from date of issuance.

Signed: X Earlie Hager Installed by: Earle Hager

Improvement Permit by: E. C. Moore date 6-24-97 Certificate of Completion by: ____ date ____

~~Existing System Inspection by:~~ Authorization to court E. C. Moore date 6-24-97 Operation Permit by: E. C. Moore date 9-18-98

HEALTH DEPT. COPY: WHITE INSPECTION COPY (FINAL): GREEN OWNER COPY (FINAL): YELLOW INSPECTION COPY (INITIAL): PINK OWNER COPY (INITIAL): GOLD

Authorization to court expires 60 mos from issue