IREDELL COUNTY HEALTH DEPARTMENT

STATESVILLE 704-878-5305 MOORESVILLE 704-664-5281

5/942 4:00

IMPROVEMENT PERMIT / CERTIFICATE OF COMPLETION / OPERATION PERMIT / EXISTING SYSTEM INSPECTION

PROPERTY DESCRIPTION NO. Troutman DATE 8-5-94 TAX MAP NO. 4PA11 Watershed: ☐ Yes ☐ No

OWNER OR CONTRACTOR Iredell vocational workshop PHONE: Business _____ Home 873 5646

ADDRESS Troutman N.C.

LOCATION US 21 S TL murdock rd 1/2 mi TL

SUBDIVISION _____ BLOCK / SECTION _____ LOT _____ LOT AREA acreage SITE CLASS. PS DESIGN FLOW 375 L.T.A.R. .3

Septic Tank: 1000 Gallons; STB 794 Date 10-7-94 ☑ New System ☐ Repair System Type: I, II, III, IV, V, VI

Pump Tank: _____ Gallons; PT _____ Date _____ System Description: Conv. Gravity

Pump Make: _____ Model _____ Serial No. _____ Repair System Description: " "

Nitrification Field: No Fields 1 Square Feet 1350 Linear Feet 450 Maintenance Agreement Required: ☐ Yes ☑ No

No Lines 4 Trench Width 36" (Vocational) Max Trench Bottom Depth 36" Gravel Depth 12"

☐ House/Mod. Home No. Bedrooms ____

☐ Mobile Home No. Bathrooms ____

☑ Business No. Employees 15

☐ Other _____


☑ Slab ☐ Crawl Space ☐ Basement w/plumbing ☐ Basement wo/plumbing

Water Supply: ☐ Individual ☐ Community ☑ Public

Comments: Addition To WorkShop will house wood working Shop

Comments:

INITIAL SITE SKETCH

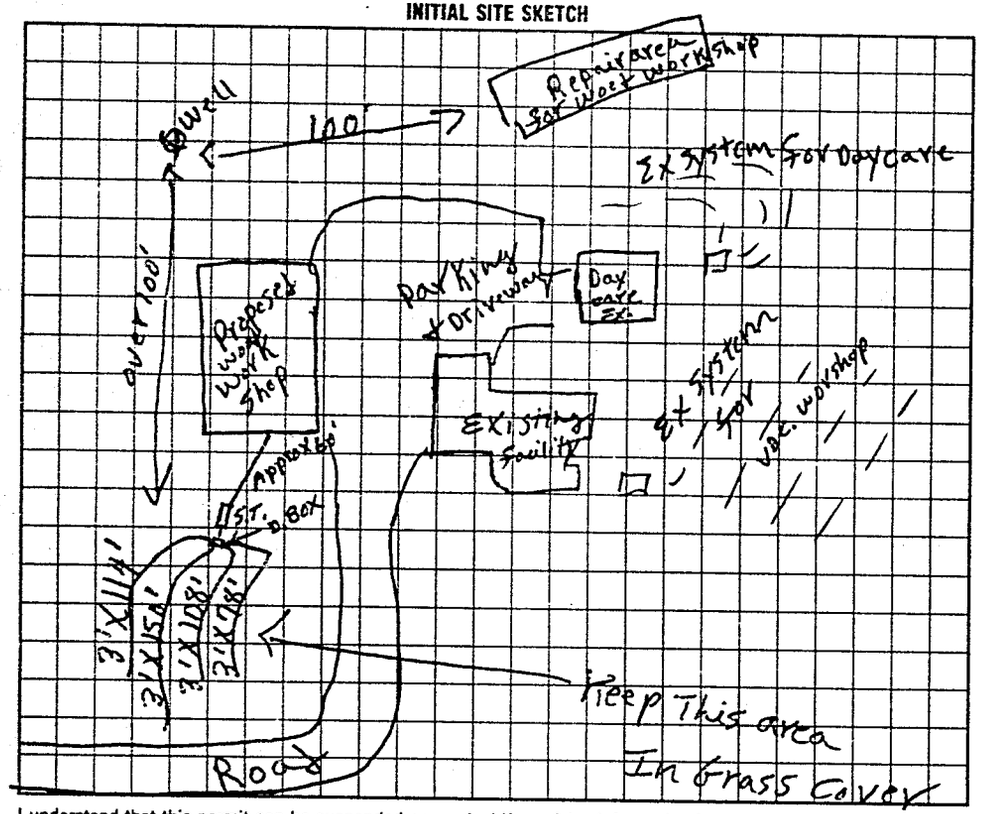

AS BUILT SKETCH

Same as initial sketch

I understand that this permit can be suspended or revoked if any false information is supplied toward securing the permit/any unauthorized changes are made to the site/any unauthorized changes are made in the installation of the system. Improvement Permit is valid for 60 months from date of issuance.

Signed: x Thomas L Wilson Jr G.L. Wilson

Improvement Permit by: P.C. Moore date 8-5-94

Existing System Inspection by: _____ date _____

Installed by: James Hutcher

Certificate of Completion by: P.C. Moore date 11-23-94

Operation Permit by: _____ date _____

HEALTH DEPT. COPY: WHITE INSPECTION COPY (FINAL): GREEN OWNER COPY (FINAL): YELLOW INSPECTION COPY (INITIAL): PINK OWNER COPY (INITIAL): GOLD

18100