IREDELL COUNTY HEALTH DEPARTMENT

Statesville Phone TR 3-7271 Mooresville Phone NO 3-1271

PERMIT TO INSTALL SEPTIC TANK

Permit NO. 7 Permit Date July 8 19 65

Owner W. T. Shue Address City

Installed By H. F. Wilson Address Mt. Ulla

Location of Property Near Little Rocky Creek


on Barium Springs

Tank		Capacity		Length of Lines		Fixtures	
Block	( )	1000	(✓)	225'	(✓)	No. of Baths	(1)
Precast	(✓)	1250	( )	250'	( )	Dishwasher	( )
		1500	( )	Other		Garbage Grdr.	( )
		Other				Other	

NOTIFY HEALTH DEPARTMENT AT LEAST EIGHT HOURS BEFORE TANK IS TO BE INSPECTED.

Final Inspection July 8 1965 Approved (✓) Disapproved ( )

Remarks

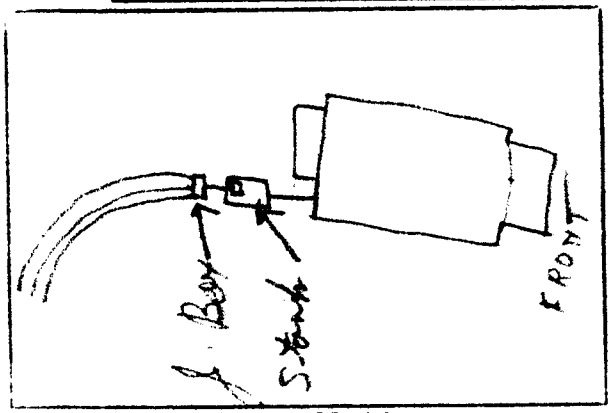

Sketch of Installation

Sanitarian