IREDELL COUNTY HEALTH DEPARTMENT

STATESVILLE 704-878-5305 MOORESVILLE 704-664-5281

IMPROVEMENT PERMIT / AUTHORIZATION TO CONSTRUCT / OPERATION PERMIT / EXISTING SYSTEM INSPECTION

PERMIT# 132784 PIN# 4733974866 5827 DATE 2-15-06

OWNER OR CONTRACTOR Stephanie J. Kinder PHONE: Business 704-682-0706 Home

ADDRESS 124 Skyuka Pl Statesville NC 28677

LOCATION 77 S. Ex exit 45 TL moseclub RD TR Skyuka 2nd Drive Right

SUBDIVISION BLOCK / SECTION LOT LOT AREA 3.382 SITE CLASS. BS DESIGN FLOW 360 L.T.A.R. .13

Septic Tank: 1000 Gallons; STB 1012 Date 3-10-06
Pump Tank: Gallons; PT Date
Pump Make: Model Serial No.
Nitrification Field: No Fields Square Feet 1200 Linear Feet 300
No Lines 3 Trench Width 36" Max Trench Bottom Depth 24" Gravel Depth N/A

☑ New System ☐ Repair System Type: I II III IV V VI
System Description: 25% Reduction
Repair System Description: 25% Pump
Maintenance Agreement Required: ☐ Yes ☐ No

☑ House/Mod. Home No. Bedrooms 3
☐ Mobile Home No. Bathrooms
☐ Business No. Employees
☐ Other


Water Supply: ☑ Individual ☐ Public ☐ Community

☐ Slab ☒ Crawl Space ☐ Basement w/plumbing ☐ Basement wo/plumbing


Comments:/Conditions:
Located on Contour
Maintain all setbacks

Comments:/Conditions:
Maintain 100' away from well
Use distribution box for equal distribution

INITIAL SITE SKETCH

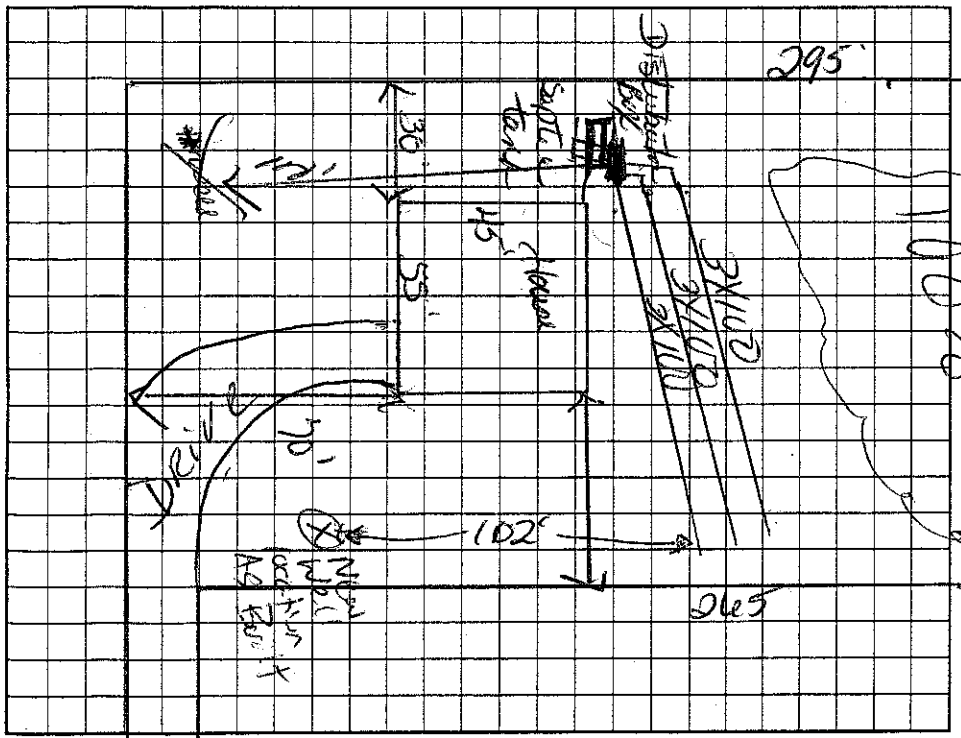

AS BUILT SKETCH

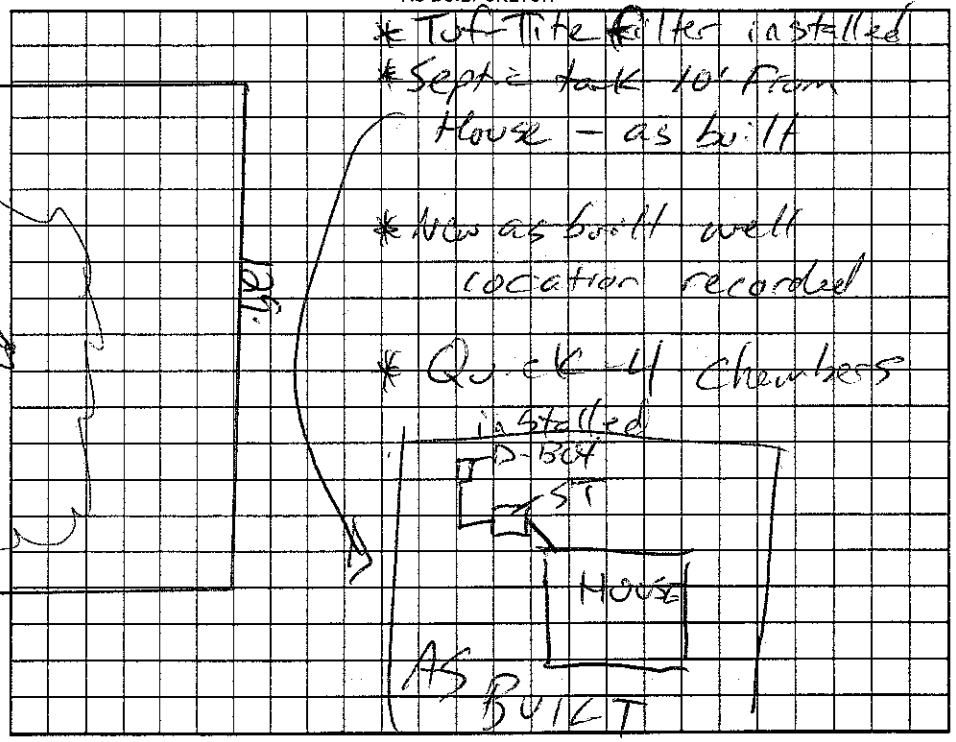

Permit can be suspended or revoked if any false information is supplied toward securing the permit/any unauthorized changes are made to the site/any unauthorized changes are made in the installation of the system. Improvement Permit with plat valid without expiration. Improvement Permit with site plan valid for sixty months. Authorization to Construct is valid for a period equal to that of Improvement Permit – not to exceed sixty months.

Signed Stephanie Kinder date 2-15-06
Improvement Permit by: date 2-15-06
Authorization to Construct by: date 2-15-06

Installed by: A-1 Septic
Operation Permit by: John C. Alf Sanitarian RS, LSS date 9-18-06
Existing System Inspection by: date

HEALTH DEPT. COPY: WHITE OWNER COPY (FINAL): YELLOW OWNER COPY (INITIAL): PINK