IREDELL COUNTY HEALTH DEPARTMENT

STATESVILLE 704-878-5305 (1) MOORESVILLE 704-664-5281

IMPROVEMENT PERMIT / AUTHORIZATION TO CONSTRUCT / OPERATION PERMIT / EXISTING SYSTEM INSPECTION

PERMIT# 089155 PIN# ~~4733905023 PT~~ 4732-99-3519 DATE 11/14/01

OWNER OR CONTRACTOR STEVE HILKERT PHONE: Business 525-1234 Home

ADDRESS 146 CARRIAGE RD. STATESVILLE NC 28677

LOCATION 215 - TL MOOSE CLUB - TL SKYUKA - TR ARLIE LOOP - ON LT

SUBDIVISION MEADOW PINES BLOCK / SECTION LOT 1 LOT AREA 1.62AC SITE CLASS. PS DESIGN FLOW 360GPD L.T.A.R. .24 gpd/ft2

Septic Tank: 1000 Gallons; STB 1012 Date 07/29/02
Pump Tank: Gallons; PT Date
Pump Make: Model Serial No.
Nitrification Field: No Fields 1 Square Feet 1500 Linear Feet 500
No Lines 5@100' Trench Width 36" Max Trench Bottom Depth 18"

☑ New System ☐ Repair System Type: I, II, III, IV, V, VI
System Description: GRAVITY CONVENTIONAL
Repair System Description: LPP
Maintenance Agreement Required: ☐ Yes ☑ No
Gravel Depth 12" ☐ Slab ☑ Crawl Space ☐ Basement w/plumbing ☐ Basement wo/plumbing


☑ House/Mod. Home No. Bedrooms 3
☑ Mobile Home No. Bathrooms 3
☐ Business No. Employees
☐ Other

Water Supply: ☑ Individual ☐ Public ☑ Community


Comments/Conditions: ORIGINAL TO LOTS - 1-2-3 COMBINED
*CALL PRIOR TO INSTALLATION IF REFLAGGING OF SYSTEM IS NEEDED.

Comments/Conditions: *SYSTEM INSTALLED DURING PERIOD OF WET SOIL.
SYSTEM WOULD NOT FIT AS SHOWN BELOW. CHANGED TO DRAWING SHOWN BELOW LEFT.

INITIAL SITE SKETCH

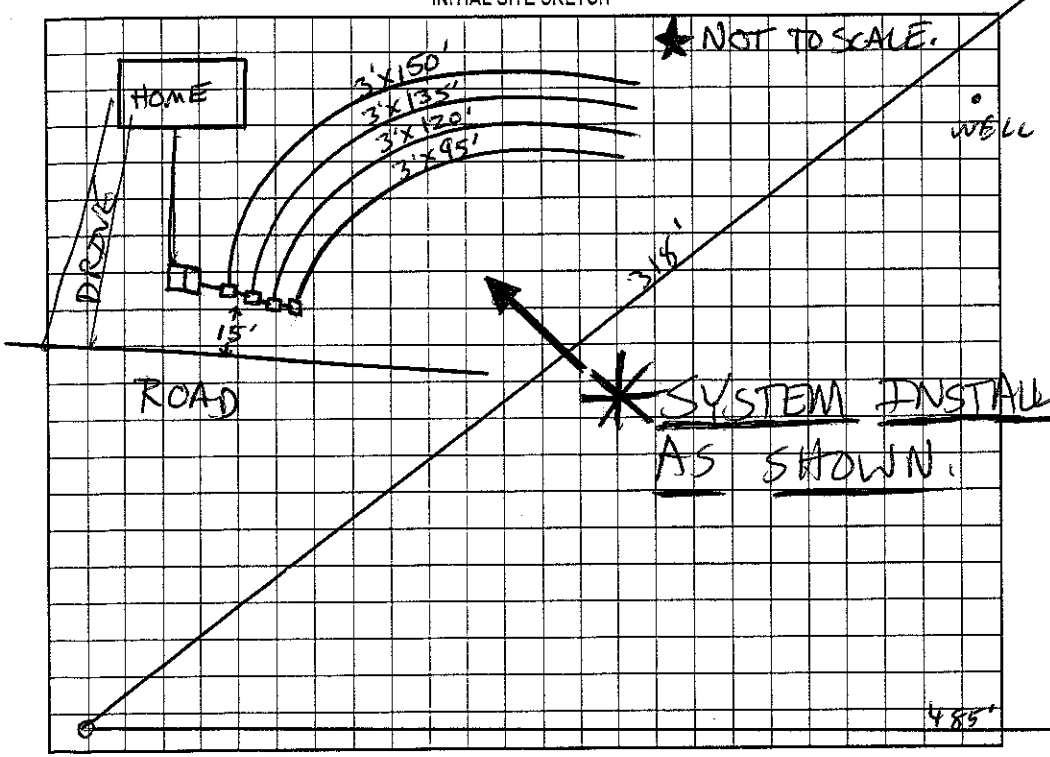

AS BUILT SKETCH

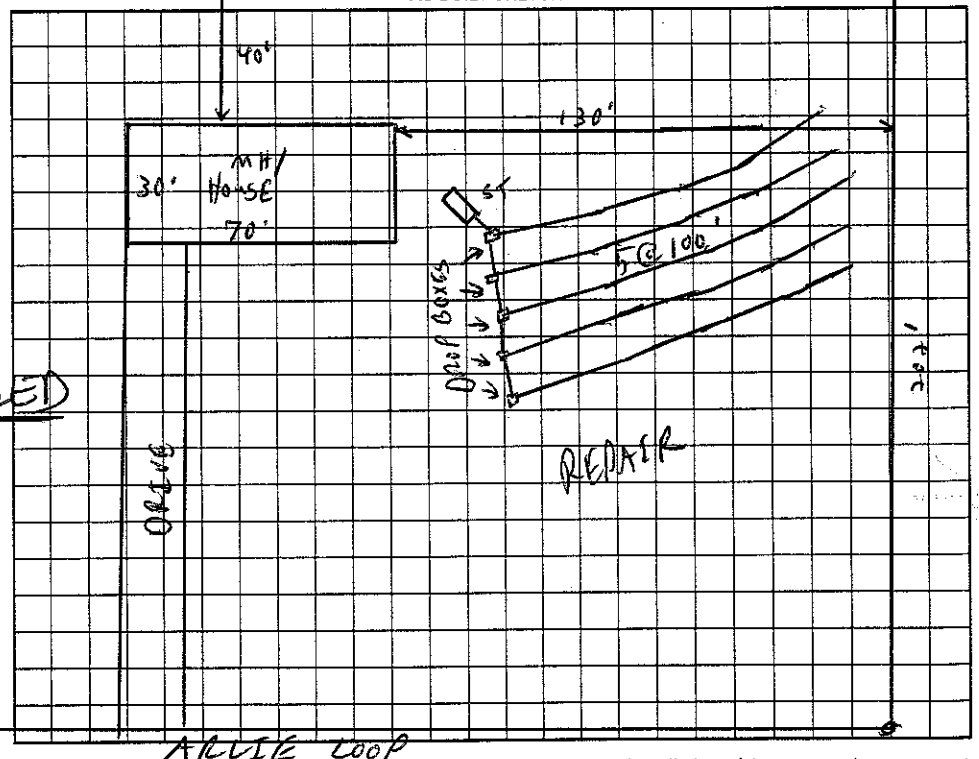

Permit can be suspended or revoked if any false information is supplied toward securing the permit/any unauthorized changes are made to the site/any unauthorized changes are made in the installation of the system. Improvement Permit with plat valid without expiration. Improvement Permit with site plan valid for sixty months. Authorization to Construct is valid for a period equal to that of Improvement Permit – not to exceed sixty months.

Signed: Cynthia Hilkert date 4/23/02
Improvement Permit by: C. [illegible] RS date 11/14/01
Authorization to Construct by: Patrick Mitchell date 02/21/03

Installed by: A-1 BACKHOE 03/14/03
Operation Permit by: Patrick Mitchell date 03/14/03
Existing System Inspection by: date

HEALTH DEPT. COPY: WHITE OWNER COPY (FINAL): YELLOW OWNER COPY (INITIAL): PINK