CK // Replaces Permit # issued 10-3-06

# IREDELL COUNTY HEALTH DEPARTMENT

STATESVILLE 704-878-5305 MOORESVILLE 704-664-5281

## IMPROVEMENT PERMIT / AUTHORIZATION TO CONSTRUCT / OPERATION PERMIT / EXISTING SYSTEM INSPECTION

PERMIT# 138312 PIN# 4733-10-0716 DATE 29 May 07

OWNER OR APPLICANT Gary Johnson PHONE: Business 704-560-1986 Home [redacted]

ADDRESS 142 Bain Ln. Mooresville, N.C.

LOCATION 160 Woodfield Drive. / Old Mtn. Rd. (L) Wallace Springs Rd. & Woodfield Dr. - Lt. on Rt.

SUBDIVISION Woodfield BLOCK / SECTION LOT 9 LOT AREA 0.96Ac. SITE CLASS. PS DESIGN FLOW 240gpd L.T.A.R. 0.3 g/sf/d

Davidson

Septic Tank: 1000g Gallons: STB 1007 Date 10-19-07

Pump Tank: Gallons: PT Date

Pump Make: Model Serial No.

Nitrification Field: No Fields 1 Square Feet 800 Linear Feet 200

No Lines 3 Trench Width 36" Max Trench Bottom Depth 36" Gravel Depth

☑ New System ☐ Repair ☐ Expansion System Type: I II III IV V VI

System Description: 25% Reduction

Repair System Description: 25% Red. - Pump

Maintenance Agreement Required: ☐ Yes ☑ No

☑ House/Mod. Home No. Bedrooms 2

☐ Mobile Home No. Persons

☐ Business No. Employees

☐ Other

Water Supply: ☑ Individual ☐ Public ☐ Community

☑ Gravity ☐ Pressure ☑ Slab ☐ Crawl Space ☐ Basement w/plumbing ☐ Basement wo/plumbing


Comments:/Conditions: Do not cut or fill over system Area

Comments:/Conditions: BOXED Fill w/ Risers


BUILDER/OWNER OK'S SYSTEM CHANGES

Dan Johnson

INITIAL SITE SKETCH 1" = 60'

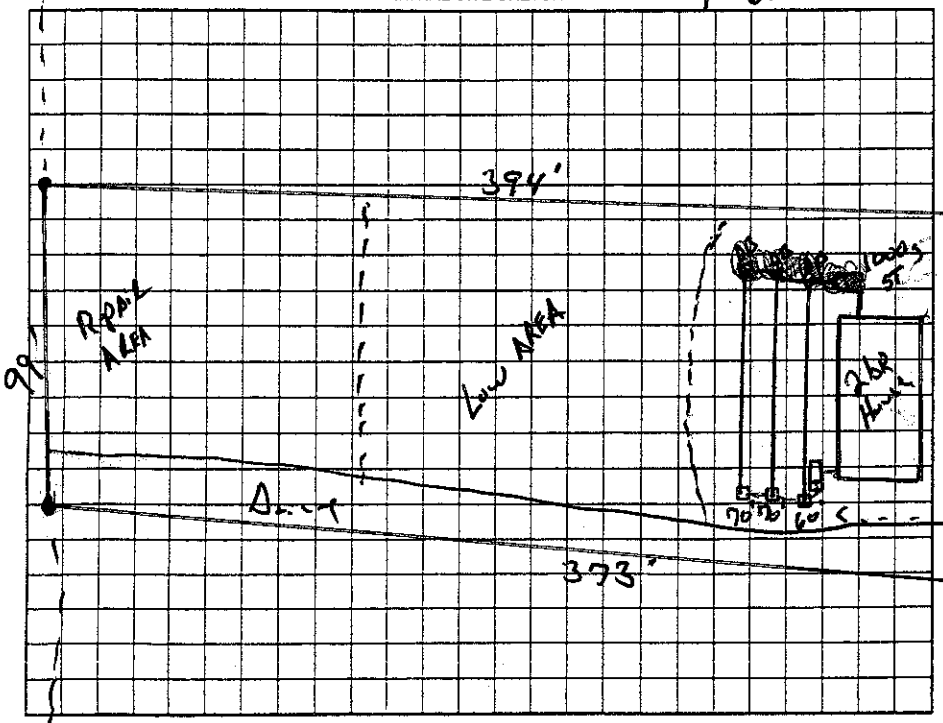


AS BUILT SKETCH

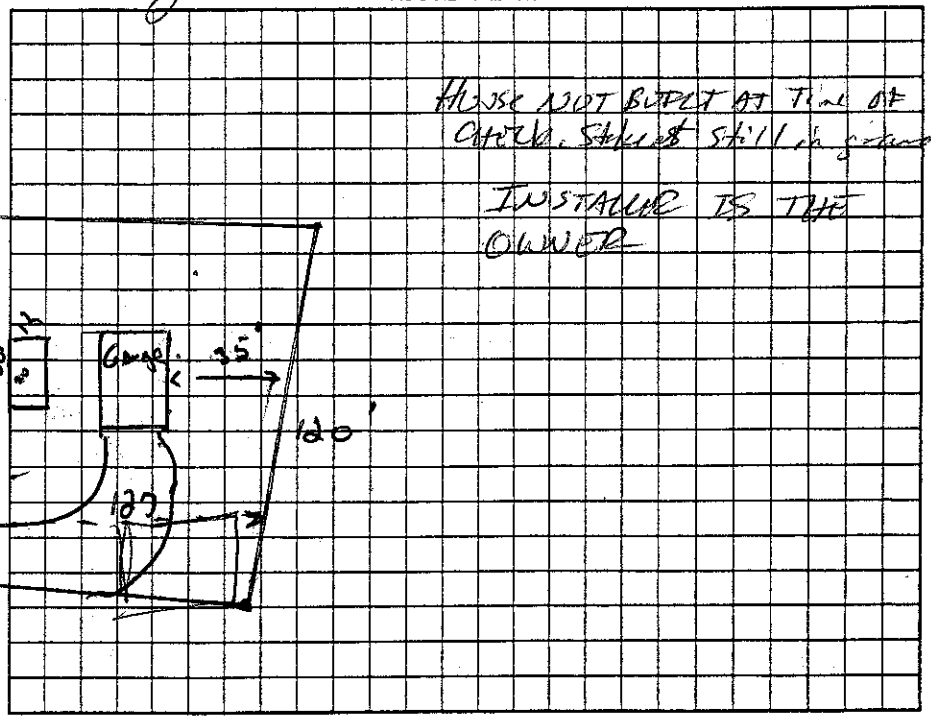


Permit can be suspended or revoked if any false information is supplied toward securing the permit/any unauthorized changes are made to the site/any unauthorized changes are made in the installation of the system. Improvement Permit with plat valid without expiration ☐ Improvement Permit with site plan valid for sixty months ☑ Authorization to Construct is valid for a period equal to that of Improvement Permit – not to exceed sixty months.

Signed: Dan Johnson date

Improvement Permit by: [redacted], R.S. date 30 May 07

Authorization to Construct by: [redacted], R.S. date 30 May 07

Installed by: Dan Gladwell

Operation Permit by: [redacted] date 12-11-07

Existing System Inspection by: date

HEALTH DEPT. COPY: WHITE OWNER COPY (FINAL): YELLOW OWNER COPY (INITIAL): PINK

Woodfield Drive