IREDELL COUNTY HEALTH DEPARTMENT

STATESVILLE 704-878-5305 MOORESVILLE 704-664-5281

IMPROVEMENT PERMIT / AUTHORIZATION TO CONSTRUCT / OPERATION PERMIT / EXISTING SYSTEM INSPECTION

PERMIT# 82150 PIN# 4733101479 DATE 2-09-00

OWNER OR CONTRACTOR William Fuller Jr. PHONE: Business Home 871 0135

ADDRESS 138 Woodfield Rd Statesville N.C.

LOCATION Old Mtn Rd Turn Wallace Sp Rd TL Woodfield 3rd Home Rt.

SUBDIVISION Southview Est BLOCK / SECTION LOT 6 LOT AREA .8 acre SITE CLASS PS DESIGN FLOW 480 L.T.A.R. .4

Septic Tank: EX 1000 Gallons, STB Date

Pump Tank: Gallons, PT Date

Pump Make: Model Serial No

Nitrification Field: No Fields 2 Square Feet 300 Linear Feet 100

No Lines 2 Trench Width 36" Max Trench Bottom Depth 36" Gravel Depth 12"

☐ New System ☐ Repair System Type: I II III IV V VI

System Description: Pulton Conv. Gravity

Repair System Description: Pump To 2550 Rd.

Maintenance Agreement Required ☐ Yes ☑ No

☑ House/Mod. Home No. Bedrooms 4

☐ Mobile Home No. Bathrooms 3

☐ Business No. Employees

☐ Other


☐ Slab ☑ Crawl Space ☐ Basement w/plumbing ☐ Basement wo/plumbing

Water Supply: ☑ Individual ☐ Public ☐ Community


Comments/Conditions:

Comments/Conditions: Ex. Line

INITIAL SITE SKETCH

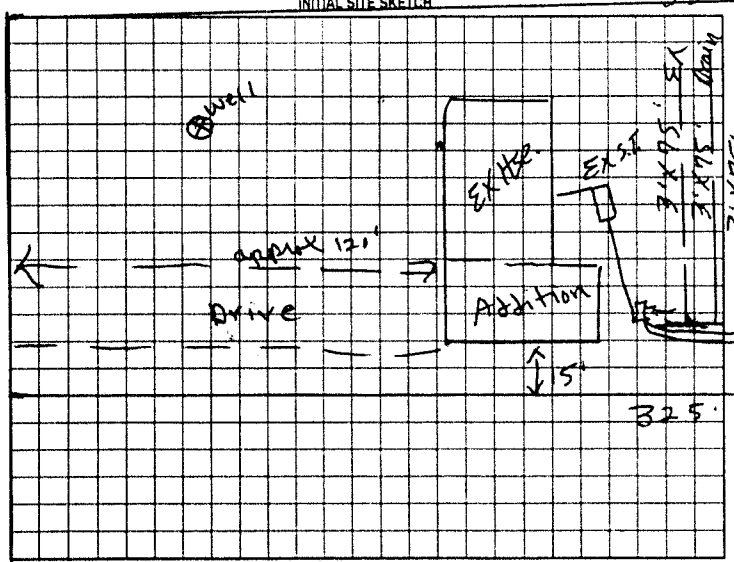

AS BUILT SKETCH

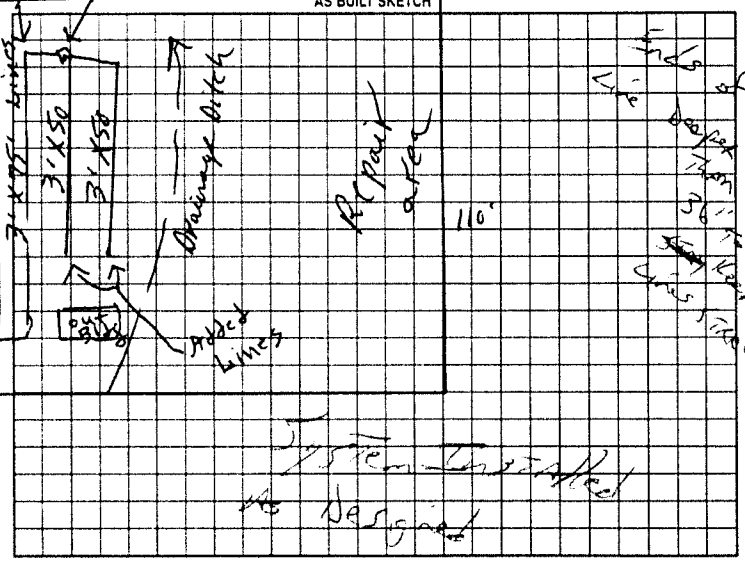

Permit can be suspended or revoked if any false information is supplied toward securing the permit/any unauthorized changes are made to the site/any unauthorized changes are made in the installation of the system. Improvement Permit with plat valid without expiration. Improvement Permit with site plan valid for sixty months. Authorization to Construct is valid for a period equal to that of Improvement Permit - not to exceed sixty months.

Signed: William Fuller Jr. date 2-09-00

Improvement Permit by: P. C. Moore date 2-09-00

Authorization to Construct by: P. C. Moore date 2-09-00

Installed by: J & J Backhoe

Operation Permit by: [signature] date 3-6-00

Existing System Inspection by: date

HEALTH DEPT COPY WHITE OWNER COPY (FINAL) YELLOW OWNER COPY (INITIAL) PINK