IREDELL COUNTY HEALTH DEPARTMENT

STATESVILLE 704-878-5305 MOORESVILLE 704-664-5281

IMPROVEMENT PERMIT / AUTHORIZATION TO CONSTRUCT / OPERATION PERMIT / EXISTING SYSTEM INSPECTION

PERMIT# 88263 PIN# 4733 10 2975 DATE

OWNER OR CONTRACTOR Martin Hendricks PHONE: Business 872-5295 Home

ADDRESS 346 New Sterling Rd Statesville NC

LOCATION ~~North~~ South Old Mt Rd ⓒ Wallace Springs Ⓑ Woodbridge Ⓑ Southview Lot on Left PAST CURVE

SUBDIVISION Southview BLOCK / SECTION LOT 22 LOT AREA .86 SITE CLASS. P3 DESIGN FLOW 360 L.T.A.R. .25

Septic Tank: 1000 Gallons; STB 1012 Date 1-28-00

Pump Tank: Gallons; PT Date

Pump Make: Model Serial No.

Nitrification Field: No Fields 1 Square Feet 1440 Linear Feet 480

No Lines 5 Trench Width 36" Max Trench Bottom Depth 36" Gravel Depth 12"

☑ New System ☐ Repair System Type: I. II. III. IV. V. VI

System Description: Conv. GRAVITY

Repair System Description: 26% Red Possible

Maintenance Agreement Required: ☐ Yes ☒ No

☑ House/Mod. Home No. Bedrooms 3

☐ Mobile Home No. Bathrooms 2

☐ Business No. Employees

☐ Other

☐ Slab ☒ Crawl Space ☐ Basement w/plumbing ☐ Basement wo/plumbing

Water Supply: ☒ Individual ☐ Public ☐ Community

Well


Comments:/Conditions: INSTALL on CONTOUR

LOCATE well 100 FT OR MAX FEASible DISTANCE from Septic System (50 FT min)

Comments:/Conditions:

N.T. TO SCALE.

INITIAL SITE SKETCH

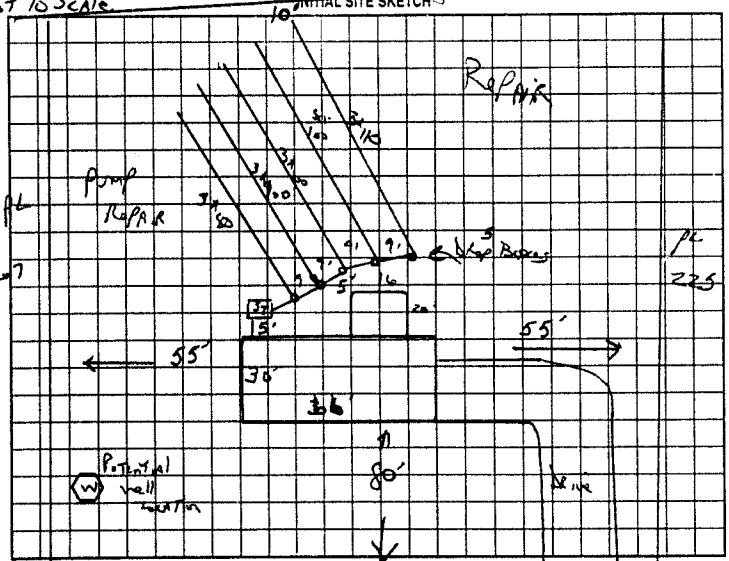

AS BUILT SKETCH

System installed As Designed

Permit can be suspended or revoked if any false information is supplied toward securing the permit/any unauthorized changes are made to the site/any unauthorized changes are made in the installation of the system. Improvement Permit with plat valid without expiration. Improvement Permit with site plan valid for sixty months. Authorization to Construct is valid for a period equal to that of Improvement Permit – not to exceed sixty months.

Signed: Martin Hendricks date 3-31-00 Installed by: Craig Thompson

Improvement Permit by: Jc Potter date March 31 2000 Operation Permit by: Jc Potter date June 2 2000

Authorization to Construct by: Jc Potter date March 31 2000 Existing System Inspection by: date

HEALTH DEPT. COPY: WHITE OWNER COPY (FINAL): YELLOW OWNER COPY (INITIAL): PINK