IREDELL COUNTY HEALTH DEPARTMENT

STATESVILLE 704-878-5305 MOORESVILLE 704-664-5281

IMPROVEMENT PERMIT / AUTHORIZATION TO CONSTRUCT / OPERATION PERMIT / EXISTING SYSTEM INSPECTION

PERMIT# _____ PIN# 4733105283 DATE 6-30-06

OWNER OR APPLICANT RICHARD NEESE PHONE: Business _____ Home 704-878-2613

ADDRESS 628 WALLACE SPRINGS RD Statesville NC 28677

LOCATION 21 NORTH @ Dove @ Wallace Springs @ Across from SOUTHVIEW SCHOOL / CANADA

SUBDIVISION _____ BLOCK / SECTION _____ LOT _____ LOT AREA 2.08 AC SITE CLASS. PS DESIGN FLOW 360 L.T.A.R. .3

Septic Tank: 1000 Gallons; STB 1012 Date 2-13-06
Pump Tank: _____ Gallons; PT _____ Date _____
Pump Make: _____ Model _____ Serial No. _____
Nitrification Field: No Fields 1 Square Feet 1200' Linear Feet 400'
No Lines 3 SPLIT Trench Width 36" Max Trench Bottom Depth 36" Gravel Depth 12"

☐ New System ☒ Repair ☐ Expansion System Type: I (II) III IV V VI
System Description: 60% CONV - NEW TANK
Repair System Description: _____
Maintenance Agreement Required: ☐ Yes ☒ No

☒ House/Mod. Home No. Bedrooms 3
☐ Mobile Home No. Persons 4
☐ Business No. Employees ____
☐ Other _____


Water Supply: ☒ Individual ☐ Public ☐ Community

☒ Gravity ☐ Pressure ☐ Slab ☒ Crawl Space ☐ Basement w/plumbing ☒ Basement wo/plumbing


Comments:/Conditions: (1) LINES ARE DRAWN 12" OUT OF LOWER (2) INSTALL LINES 36" DEEP DUE TO BETTER SOILS & INSTALL SO IT WILL BACK UP TO BOXES

Comments:/Conditions: (3) SEPTIC MUST BE 100' FROM BORED WELL (4) THIS PERMIT SERVES AS NOTICE OF VIOLATION & MUST BE REPAIRED WITHIN 30 DAYS.

INITIAL SITE SKETCH "NOT TO SCALE"

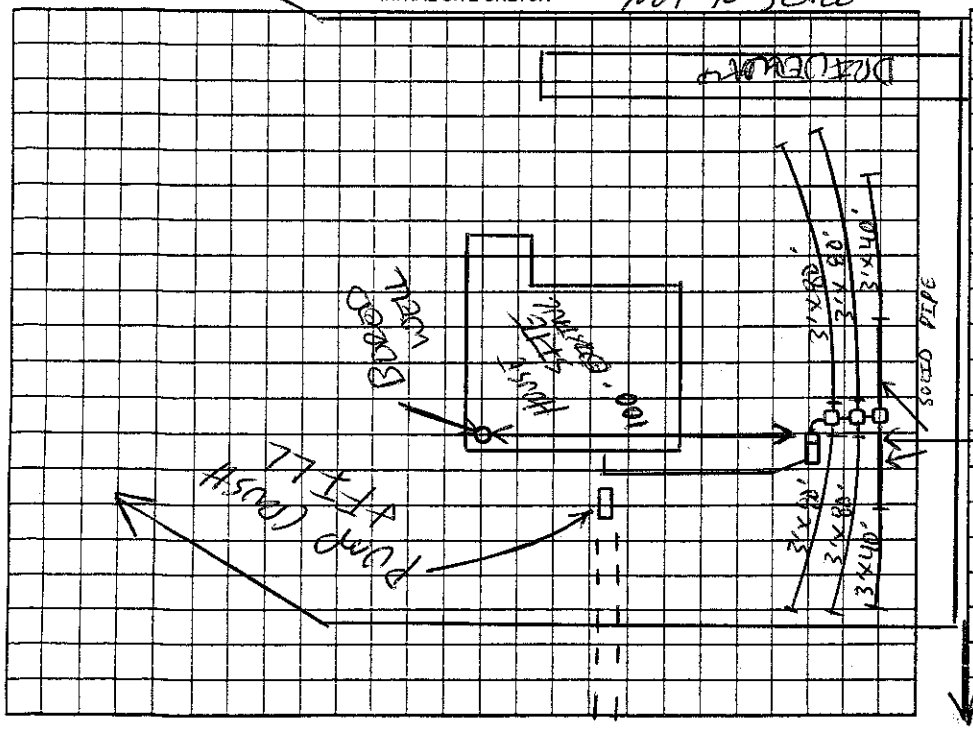

AS BUILT SKETCH

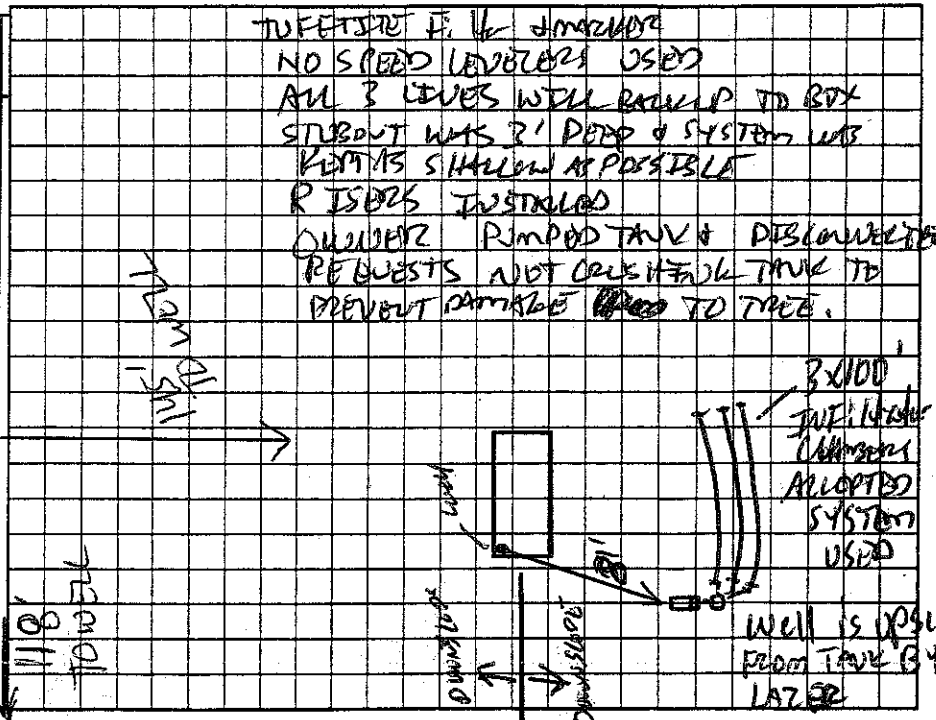

Permit can be suspended or revoked if any false information is supplied toward securing the permit/any unauthorized changes are made to the site/any unauthorized changes are made in the installation of the system. Improvement Permit with plat valid without expiration ☐ Improvement Permit with site plan valid for sixty months ☒ Authorization to Construct is valid for a period equal to that of Improvement Permit – not to exceed sixty months.

(*) Signed: _____ date 7-7-06 Installed by: A-1 BACKHOE

Improvement Permit by: _____ date 6-30-06 Operation Permit by: _____ date 7-24-06

Authorization to Construct by: _____ date 6-30-06 Existing System Inspection by: _____ date _____

HEALTH DEPT. COPY: WHITE OWNER COPY (FINAL): YELLOW OWNER COPY (INITIAL): PINK