IREDELL COUNTY HEALTH DEPARTMENT

(SEPTIC TANK) IMPROVEMENTS PERMIT AND CERTIFICATE OF COMPLETION
(Ground Absorption Sewage Disposal System -- G. S. Chapter 130-Article 13C)

OWNER OR CONTRACTOR D E R. STEVENSON DATE 7-21-89 PERMIT NO. D14

PHONE: Business _____ Home _____


SUBDIVISION NAME _____ LOT NO. _____ SECTION OR BLOCK NO. _____

House (✓) Mobile Home ( ) Business ( ) Other Repair.

No. Bedrooms 1 No. Bathrooms 1
Garbage Disposal Unit Yes ( ) No (✓)
Auto. Dishwasher Yes ( ) No (✓)
Auto. Wash. Machine Yes (✓) No ( )
Site Suitable Yes (✓) No ( )


Character & Porosity of Soil _____
Percolation Rate _____
Topography _____
Depth to Water Table Repair
Rock or other impervious formations _____

Lot Area Ample

_____ Basement with Plumbing _____ Basement without Plumbing (✓) No Basement

Size of Tank EXISTING Gals.
Nitrification Field:
No. of Lines 1
Sq. Ft. 300 Linear Ft. 100
Depth of Stone in Lines 12"
Water Supply: Individual (✓)
Public ( )

Plot Plan of System

 

Installed by James Hudler

I understand and agree to install septic tank system as specified on this Improvements Permit.

Signed: _____

IMPROVEMENTS PERMIT BY Steve Brown

COMMENTS: Tank pumped & new tee installed. Flow divider used to connect old & new lines.

CERTIFICATE OF COMPLETION BY Steve Brown DATE 7-11-89.

EXISTING SYSTEM CHECKED BY: _____ DATE _____

CONSTRUCTION MUST COMPLY WITH ALL OTHER APPLICABLE STATE AND LOCAL REGULATIONS.

Permit is VOID if any unauthorized changes are made in installation of system and/or if any false information is supplied in making Improvements Permit.

Health Dept. Copy: White Inspection Dept. Copy: Yellow Sanitarian's Copy: Pink Owner's Copy: Gold