IREDELL COUNTY HEALTH DEPARTMENT

STATESVILLE 704-878-5305 MOORESVILLE 704-664-5281

IMPROVEMENT PERMIT / CERTIFICATE OF COMPLETION / OPERATION PERMIT / EXISTING SYSTEM INSPECTION

PROPERTY DESCRIPTION NO. 23592 067450 DATE 5-8-96 TAX MAP NO. 6C-5-A-8 Watershed: ☐ Yes ☐ No

OWNER OR CONTRACTOR Gary Estes PHONE: Business Home 528-3222

ADDRESS 155 Autumn Leaf Rd Troutman, N.C.

LOCATION Hwy 21S TR Hill Haven Th Wallace Isp Rd TR Woodfield TR Southview 11th lot Rt

SUBDIVISION Southview West BLOCK / SECTION LOT 8 LOT AREA .979 acres SITE CLASS PS DESIGN FLOW 360 L.T.A.R. 13

Septic Tank: 1000 Gallons; STB 794 Date 11-29-97

Pump Tank: Gallons; PT Date

Pump Make: Model Serial No.

Nitrification Field: No Fields 1 Square Feet 1200 Linear Feet 400

No Lines 3 Trench Width 36" Max Trench Bottom Depth 36" Gravel Depth 12"

☑ New System ☐ Repair System Type: I, II, III, IV, V, VI

System Description: Conv. Gravity

Repair System Description: Pump To Chambers

Maintenance Agreement Required: ☐ Yes ☐ No

☑ House/Mod. Home No. Bedrooms 3

☐ Mobile Home No. Bathrooms 2½

☐ Business No. Employees

☐ Other

☐ Slab ☐ Crawl Space ☑ Basement w/plumbing ☐ Basement wo/plumbing

Water Supply: ☑ Individual ☐ Community ☐ Public


Comments:

⊗ well Next door

Comments:

X Tank Turned slightly

INITIAL SITE SKETCH

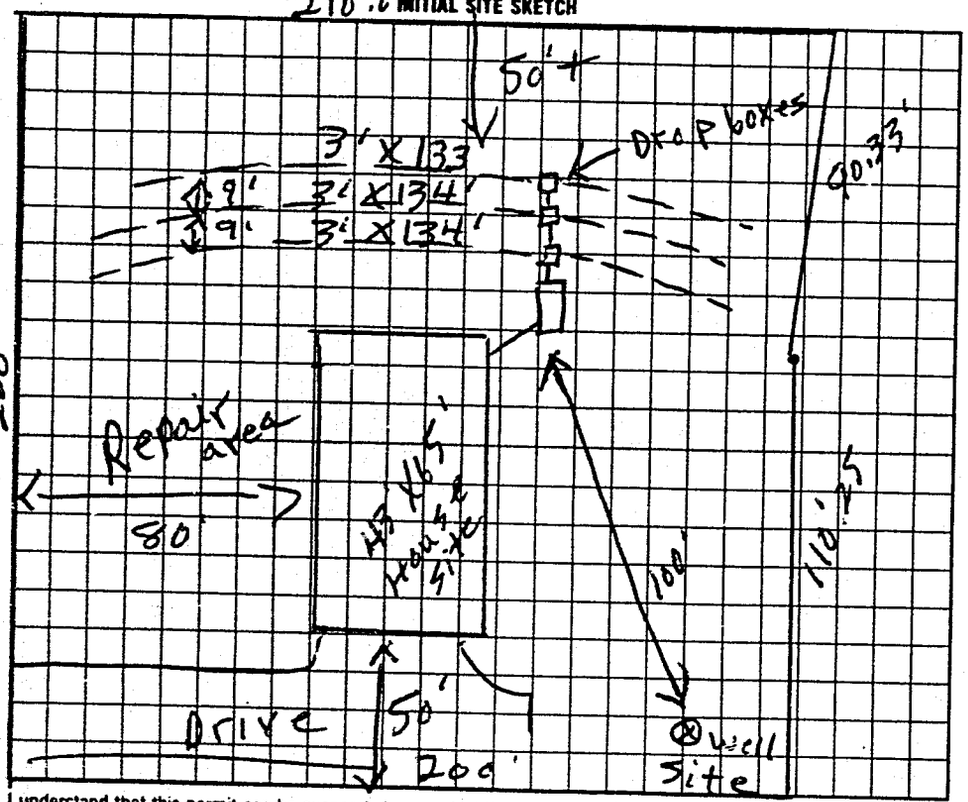

AS BUILT SKETCH

Installed as shown

I understand that this permit can be suspended or revoked if any false information is supplied toward securing the permit/any unauthorized changes are made to the site/any unauthorized changes are made in the installation of the system.

Signed: Gary Estes

Improvement Permit by: P. C. Moore date 5-8-96

Existing System Inspection by: P. C. Moore date 5-8-96

Installed by: Rusty Dobson

Certificate of Completion by: date

Operation Permit by Mark C. Watts, RS date 2-25-98

HEALTH DEPT COPY WHITE INSPECTION COPY (FINAL) GREEN OWNER COPY (FINAL) YELLOW INSPECTION COPY (INITIAL) PINK OWNER COPY (INITIAL) GOLD

authorization to count

authorization to count Expires 60 mos from issue