IREDELL COUNTY HEALTH DEPARTMENT

STATESVILLE 704-878-5305 MOORESVILLE 704-664-5281

IMPROVEMENT PERMIT / AUTHORIZATION TO CONSTRUCT / OPERATION PERMIT / EXISTING SYSTEM INSPECTION

PERMIT# 126158 PIN# 4733-12-1355 DATE 2/28/05

OWNER OR CONTRACTOR Brad Pike Builders Inc. PHONE: Business (704)902-1344 Home

ADDRESS 123 Sullivan Farm Rd. Statesville N.C 28625

LOCATION Wallace Springs Rd Turn on Westfield Dr. TR Southview Dr. on Right at end

SUBDIVISION Southview Estates BLOCK / SECTION LOT 12 LOT AREA 1.3 Ac SITE CLASS. PS DESIGN FLOW 360gpd L.T.A.R. .3

Septic Tank: 1000 Gallons; STB 1012 Date 3-7-05
Pump Tank: Gallons; PT Date
Pump Make: Model Serial No.
Nitrification Field: No Fields 1 Square Feet 900 Linear Feet 300
No Lines 4 Trench Width 36" Max Trench Bottom Depth 36" Gravel Depth N/A

☑ New System ☐ Repair System Type: I, II, III, IV, V, VI
System Description: Gravity 25% Reduction
Repair System Description: Gravel/pumped 25% Reduction
Maintenance Agreement Required: ☐ Yes ☑ No


☑ House/Mod. Home No. Bedrooms 3
☐ Mobile Home No. Bathrooms
☐ Business No. Employees
☐ Other
☐ Slab ☑ Crawl Space ☐ Basement w/plumbing ☐ Basement wo/plumbing

Water Supply: ☑ Individual ☐ Public ☐ Community


Comments:/Conditions:

Comments:/Conditions: TUFTITE Filter FABRIC INSTALLED AS DRAWN

INITIAL SITE SKETCH

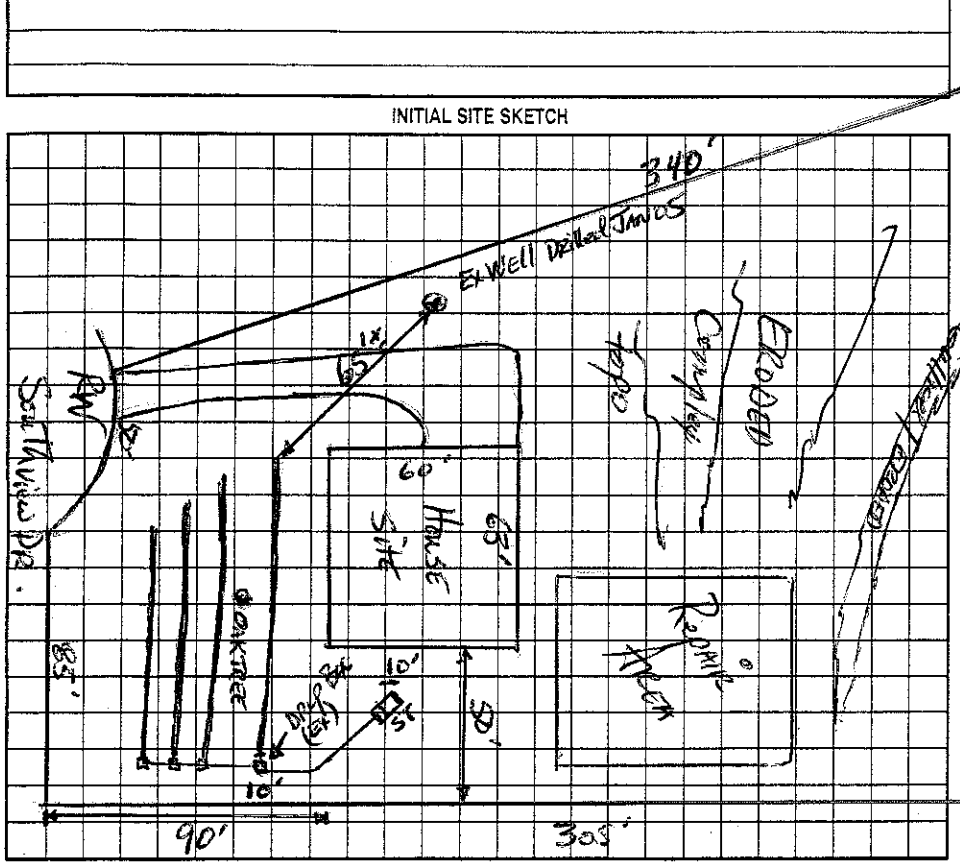

AS BUILT SKETCH

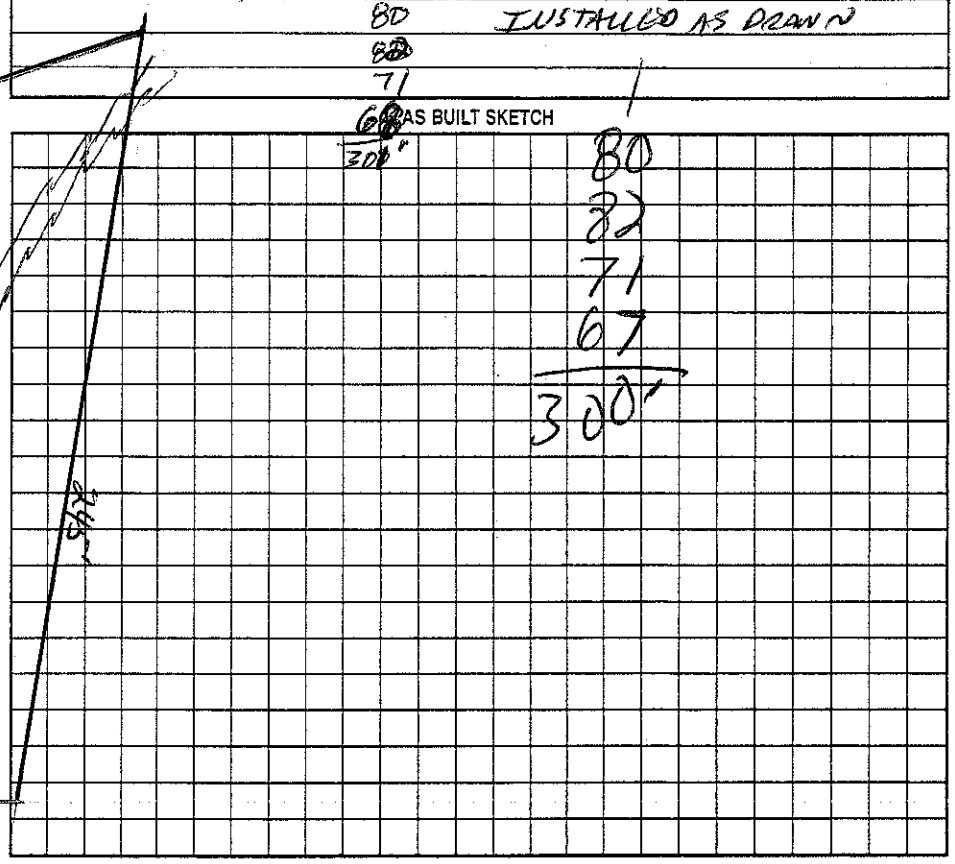

Permit can be suspended or revoked if any false information is supplied toward securing the permit/any unauthorized changes are made to the site/any unauthorized changes are made in the installation of the system. Improvement Permit with plat valid without expiration. Improvement Permit with site plan valid for sixty months. Authorization to Construct is valid for a period equal to that of Improvement Permit – not to exceed sixty months.

Signed: date 2/28/05 Installed by: Tommy Frye

Improvement Permit by: date 2/28/05 Operation Permit by: date 9-1-05

Authorization to Construct by: date 2/28/05 Existing System Inspection by: date

HEALTH DEPT. COPY: WHITE OWNER COPY (FINAL): YELLOW OWNER COPY (INITIAL): PINK