IREDELL COUNTY HEALTH DEPARTMENT

STATESVILLE 704-878-5305 MOORESVILLE 704-664-5281 (C1)

IMPROVEMENT PERMIT / AUTHORIZATION TO CONSTRUCT / OPERATION PERMIT / EXISTING SYSTEM INSPECTION

PERMIT# 130616 PIN# 4733-28-3271 DATE 9-7-05

OWNER OR CONTRACTOR DAVID MILLSAPS PHONE: Business 704-902-4532 Home 704-873-1331

ADDRESS 1124 RADIO ROAD STATESVILLE, NC 28677

LOCATION BUFFALO SHOALS ROAD TO SLINGSHOT ROAD, TR BELFAST ROAD, TR EDWARDS LANE, MH ON LOOP

SUBDIVISION PINE RIDGE MHP BLOCK / SECTION ____ LOT 2 LOT AREA LIMITED SITE CLASS. P5 DESIGN FLOW 360 L.T.A.R. EXISTING

Septic Tank: EXISTING Gallons; STB ____ Date ____

Pump Tank: ____ Gallons; PT ____ Date ____

Pump Make: ____ Model ____ Serial No. ____

Nitrification Field: No Fields ____ Square Feet ____ Linear Feet EXISTING

No Lines ____ Trench Width ____ Max Trench Bottom Depth ____ Gravel Depth EXISTING

☐ New System ☐ Repair System Type: (II) III, IV, V, VI

System Description: CONVENTIONAL GRAVITY

Repair System Description: ____

Maintenance Agreement Required: ☐ Yes ☑ No

☐ Slab ☑ Crawl Space ☐ Basement w/plumbing ☐ Basement wo/plumbing

☐ House/Mod. Home No. Bedrooms ____

☐ Mobile Home No. Bathrooms ____

☐ Business No. Employees ____

☐ Other ____


Water Supply: ☐ Individual ☑ Public ☑ Community

Comments:/Conditions:

Comments:/Conditions:

INITIAL SITE SKETCH

AS BUILT SKETCH

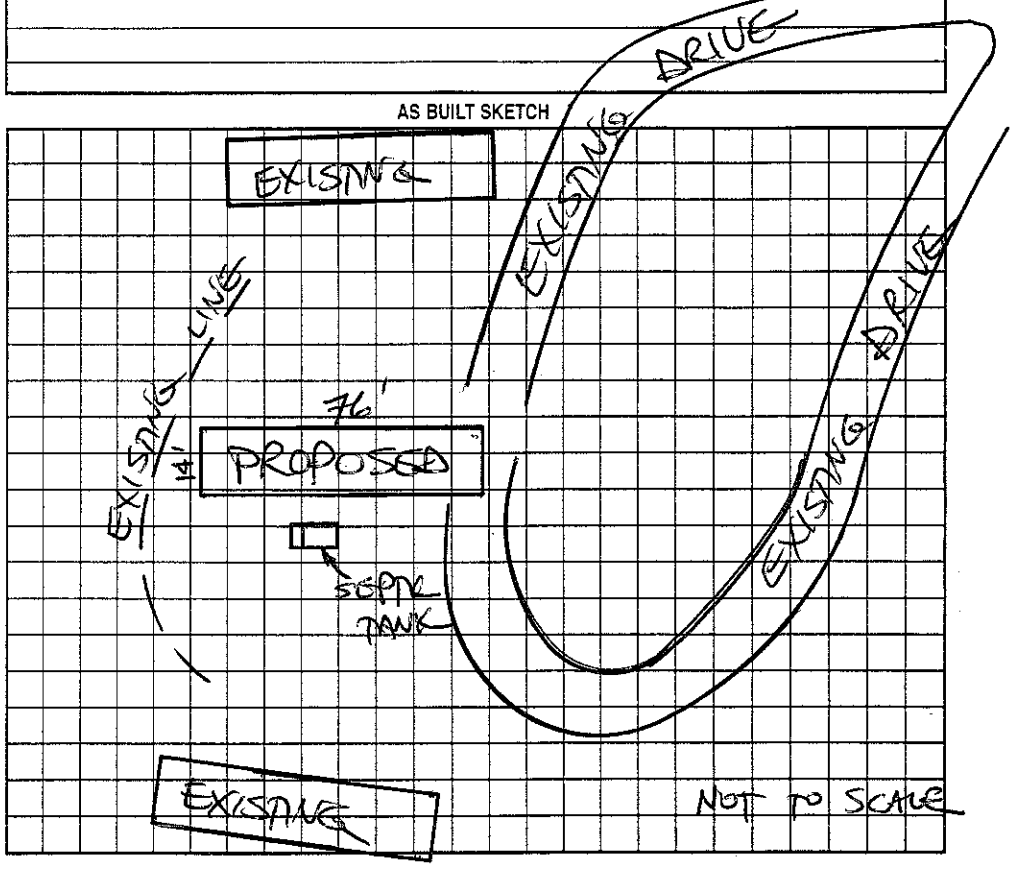

Permit can be suspended or revoked if any false information is supplied toward securing the permit/any unauthorized changes are made to the site/any unauthorized changes are made in the installation of the system. Improvement Permit with plat valid without expiration. Improvement Permit with site plan valid for sixty months. Authorization to Construct is valid for a period equal to that of Improvement Permit – not to exceed sixty months.

Signed: Bill Tenyue date 9/16/05

Improvement Permit by: ____ date ____

Authorization to Construct by: ____ date ____

Installed by: ____

Operation Permit by: ____ date ____

Existing System Inspection by: STEVE HENDRICK date 9-7-05

HEALTH DEPT. COPY: WHITE OWNER COPY (FINAL): YELLOW OWNER COPY (INITIAL): PINK