IREDELL COUNTY HEALTH DEPARTMENT

STATESVILLE 704-878-5305 MOORESVILLE 704-664-5281

IMPROVEMENT PERMIT / AUTHORIZATION TO CONSTRUCT / OPERATION PERMIT / EXISTING SYSTEM INSPECTION

PERMIT# City of Statesville 83974 PIN# Tax map 4733-28-3477 DATE Sept 20, 99

OWNER OR CONTRACTOR Jack Wooten PHONE: Business 873 2866 Home

ADDRESS 124 Edwards Rd. Statesville Nc

LOCATION Buffalo Shoals Rd (L) Slingshot (R) Bed/Fast (R) Edwards Rd To End on Right

SUBDIVISION BLOCK / SECTION LOT LOT AREA .6Ac +- SITE CLASS. PS DESIGN FLOW 360 L.T.A.R. .3

Septic Tank: 1000 Gallons; STB 312 Date 10 29 99
Pump Tank: Gallons; PT Date
Pump Make: Model Serial No.
Nitrification Field: No Fields 1 Square Feet 1200 Linear Feet 300
No Lines 4 Trench Width 36" Max Trench Bottom Depth 36" Gravel Depth N/A

☐ New System ☐ Repair System Type: I, II, III, IV, V, VI
System Description: 25% Reduction Gravity
Repair System Description: Same
Maintenance Agreement Required: ☐ Yes ☒ No


☐ House/Mod. Home No. Bedrooms 3
☒ Mobile Home No. Bathrooms 2
☐ Business No. Employees
☐ Other
☐ Slab ☒ Crawl Space ☐ Basement w/plumbing ☐ Basement wo/plumbing

Water Supply: ☒ Individual ☐ Public ☐ Community
Well


Comments/Conditions: Divert surface ditch away from Septic System

Comments/Conditions

INITIAL SITE SKETCH

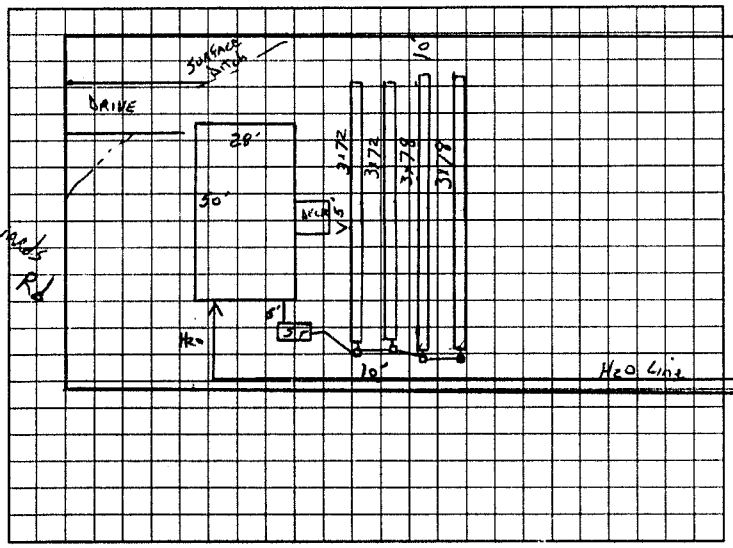

AS BUILT SKETCH

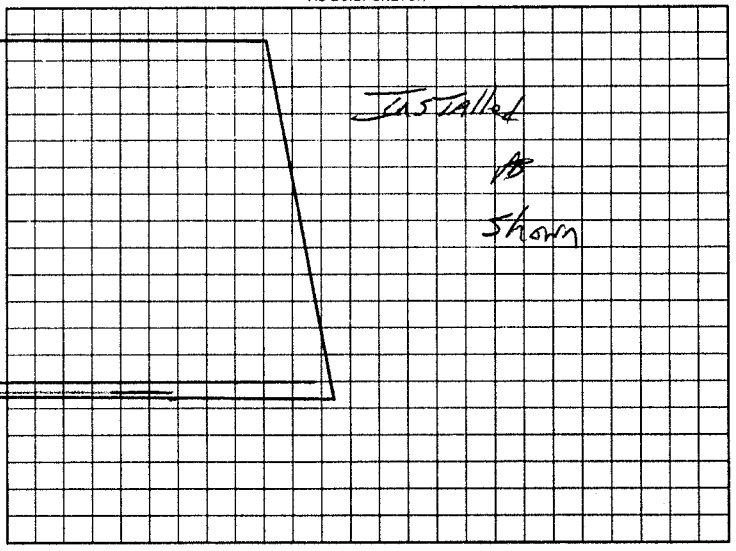

Permit can be suspended or revoked if any false information is supplied toward securing the permit/any unauthorized changes are made to the site/any unauthorized changes are made in the installation of the system. Improvement Permit with plat valid without expiration. Improvement Permit with site plan valid for sixty months. Authorization to Construct is valid for a period equal to that of Improvement Permit – not to exceed sixty months.

Signed: Jack B. Wooten date 9-21-99 Installed by: Tim Ammons

Improvement Permit by: JC Potter date Sept 20 99 Operation Permit by: JC Potter date Jan 3 2000

Authorization to Construct by: JC Potter date Sept 21 99 Existing System Inspection by: date

HEALTH DEPT. COPY: WHITE OWNER COPY (FINAL): YELLOW OWNER COPY (INITIAL): PINK