IREDELL COUNTY HEALTH DEPARTMENT

STATESVILLE 704-878-5305 MOORESVILLE 704-664-5281

IMPROVEMENT PERMIT / AUTHORIZATION TO CONSTRUCT / OPERATION PERMIT / EXISTING SYSTEM INSPECTION

PERMIT# Repair PIN# 4733-30-3821 DATE 2/22/02

OWNER OR CONTRACTOR Richard & Lisa Martin PHONE: Business — Home (704) 924-8329

ADDRESS 760 Avery Rd Statesville N.C. 28677

LOCATION 115 S Sketon Ave, ② Hill Haven Rd, ① Wallace Springs Rd ③ Avery Rd, 3rd House on Right

SUBDIVISION — BLOCK / SECTION — LOT — LOT AREA .7 Ac. SITE CLASS — DESIGN FLOW 360 L.T.A.R. —

Septic Tank: 1,000 Gallons; STB — Date —

Pump Tank: — Gallons; PT — Date —

Pump Make: — Model — Serial No. —

Nitrification Field: No Fields 1 Square Feet 625 Linear Feet 180'

No Lines 2 Trench Width 36" Max Trench Bottom Depth ±36" Gravel Depth 18"

☐ New System ☒ Repair System Type: I, II, III, IV, V, VI

System Description: —

Repair System Description: County Line,

Maintenance Agreement Required: ☐ Yes ☒ No

☒ House/Mod Home No Bedrooms 3

☐ Mobile Home No. Bathrooms 1½

☐ Business No. Employees —

☐ Other —


☐ Slab ☐ Crawl Space ☐ Basement w/plumbing ☒ Basement wo/plumbing

Water Supply: ☒ Individual ☐ Public ☐ Community

Comments/Conditions: ① Add two lines do one line then call For Health Dept Inspection, before day next line ② Add(1) Dist box, using all lines ③ Pump Tank before repair ④ The permit serves as Notice of Violation (30 days to repair)

Comments/Conditions:

INITIAL SITE SKETCH

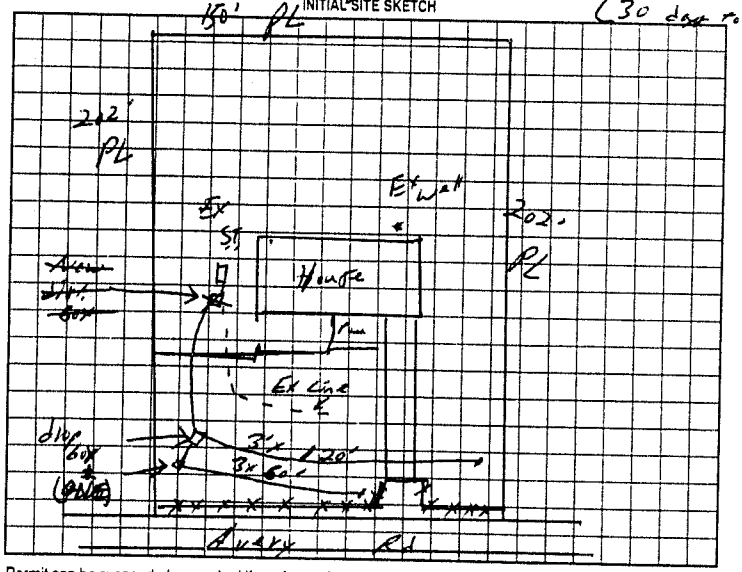

AS BUILT SKETCH

SYSTEM REPAIRED USING 180 FEET OF "INFILTRATOR" CHAMBERS

Permit can be suspended or revoked if any false information is supplied toward securing the permit/any unauthorized changes are made to the site/any unauthorized changes are made in the installation of the system. Improvement Permit with plat valid without expiration. Improvement Permit with site plan valid for sixty months. Authorization to Construct is valid for a period equal to that of Improvement Permit – not to exceed sixty months.

Signed: Richard Martin date 2/27/02 Installed by: JAMES HUDLER

Improvement Permit by: William O. Johnson date 2/22/02 Operation Permit by: STEVE HENRICK date 4-22-02

Authorization to Construct by: William O. Johnson date 2/22/02 Existing System Inspection by: — date —

HEALTH DEPT. COPY. WHITE OWNER COPY (FINAL). YELLOW OWNER COPY (INITIAL). PINK