IREDELL COUNTY HEALTH DEPARTMENT - *ENVIRONMENTAL HEALTH* ☐ STATESVILLE OFFICE 704-878-5305 ☐ MOORESVILLE OFFICE 704-664-5281

IMPROVEMENT PERMIT / AUTHORIZATION TO CONSTRUCT / OPERATION PERMIT / EXISTING SYSTEM INSPECTION

PERMIT # 1608459 PIN # 4733-43-8181 DATE SEPTEMBER 9, 2011

OWNER WENDELL COOK APPLICANT: SAME PHONE: Home/Cell # 704-872-1125 Business # 704-880-2395

SITE ADDRESS 416 WALLACE SPRINGS ROAD OWNER / APPLICANT ADDRESS SAME

SITE DIRECTIONS US 21 SOUTH, TR HILLHAVEN ROAD, TR WALLACE SPRINGS ROAD 4TH HOUSE ON LEFT

SUBDIVISION BLOCK / SECTION LOT # LOT AREA 0.98 AC DESIGN FLOW — L.T.A.R.

Septic Tank EX Gallons: STB Date

Pump Tank Gallons: P T Date

Pump Make Model Serial #

No. Nitrification Fields: 1 No. Lines Linear Feet EX

Trench Width Max. Trench Bottom Depth Gravel Depth

☐ New System ☐ Repair ☐ Expansion System Type I II III IV V VI

System Description: CONV. GRAVITY

Repair System Description:

Maintenance Agreement Required ☐ YES ☑ NO

☑ GRAVITY ☐ PRESSURE

☑ Residence No. Bedrooms —

☐ Business No. Persons

☐ Other No. Employees

☐ Slab ☐ Crawl Space

☐ Basement w/plumbing ☐ Basement w/o plumbing

Water Supply: ☑ Private ☐ Public ☐ Community

Comments / Conditions

THE PROPOSED RAMP DOES NOT APPEAR TO AFFECT THE EXISTING SEPTIC SYSTEM

EXISTING PERMIT NOT FOUND.

INITIAL SITE SKETCH


Location of the proposed RAMP addition does not appear to impact the existing on-site septic system.**NOTE:

R. STEVE HENDRICK REHS

Date: 9-7-2011

ICHD-Environmental Health Division

AS BUILT SKETCH

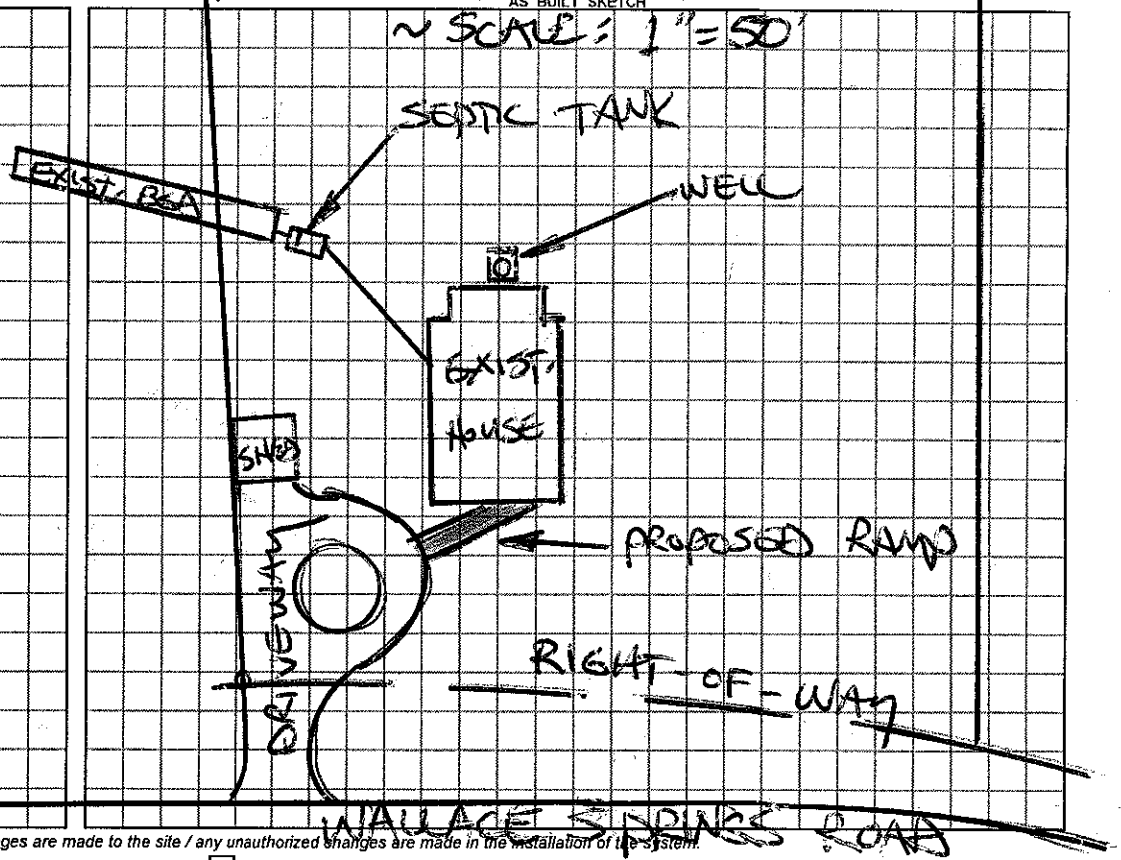

Permit can be suspended or revoked if any false information is supplied toward securing the permit / any unauthorized changes are made to the site / any unauthorized changes are made in the installation of the system.

☐ ***IMPROVEMENT PERMIT*** *with plat valid without expiration.* ☐ ***IMPROVEMENT PERMIT*** *with plat valid without expiration. site plan valid 60 mo.* ☐ ***AUTHORIZATION TO CONSTRUCT*** valid for period equal to IMPROVEMENT PERMIT--not to exceed 60 mo.

Owner / Applicant Signature: Date

IMPROVEMENT PERMIT by: REHS Date

AUTHORIZATION TO CONSTRUCT by: REHS Date

YOU SHOULD CONTACT A LOCATOR SERVICE PRIOR TO ANY EXCAVATION

Installed by:

OPERATION PERMIT by: REHS Date

Existing System Inspected by: R STEVE HENDRICK REHS Date 9-7-11

White Copy -- Environmental Health YELLOW COPY (Final) Owner / Applicant PINK COPY (initial) Owner / Applicant