IREDELL COUNTY HEALTH DEPARTMENT

STATESVILLE 704-878-5305 MOORESVILLE 704-664-5281

IMPROVEMENT PERMIT / CERTIFICATE OF COMPLETION / OPERATION PERMIT / EXISTING SYSTEM INSPECTION

PROPERTY DESCRIPTION NO. Statesville DATE 4-11-97 ~~TAX MAP NO.~~ Pin No. 4733-54-3664 Watershed: ☐ Yes ☒ No

OWNER OR CONTRACTOR Julie Sherrill PHONE: Business _____ Home _____

ADDRESS 314 N Eastway Dr. Troutman

LOCATION Old mtn Rd. turn Wallace SP. before 3rd curb on left

SUBDIVISION _____ BLOCK / SECTION _____ LOT _____ LOT AREA ~~1.56~~ acres SITE CLASS. PS DESIGN FLOW 360 L.T.A.R. .13

Septic Tank: 1000 Gallons; STB 1012 Date 10-13-97

Pump Tank: _____ Gallons; PT _____ Date _____

Pump Make: _____ Model _____ Serial No. _____

Nitrification Field: No Fields 1 Square Feet 1200 Linear Feet 400

No Lines 3 Trench Width 36" Max Trench Bottom Depth 36" Gravel Depth 12"

☒ New System ☐ Repair System Type: I, (II), III, IV, V, VI

System Description: Conv. Gravity

Repair System Description: Gravity Chambers

Maintenance Agreement Required: ☐ Yes ☐ No

☐ House/Mod. Home No. Bedrooms 3

☐ Mobile Home No. Bathrooms 2½

☐ Business No. Employees _____

☐ Other _____

☐ Slab ☒ Crawl Space ☐ Basement w/plumbing ☐ Basement wo/plumbing


Water Supply: ☒ Individual ☐ Community ☐ Public

Comments:

212'

Drive


INITIAL SITE SKETCH

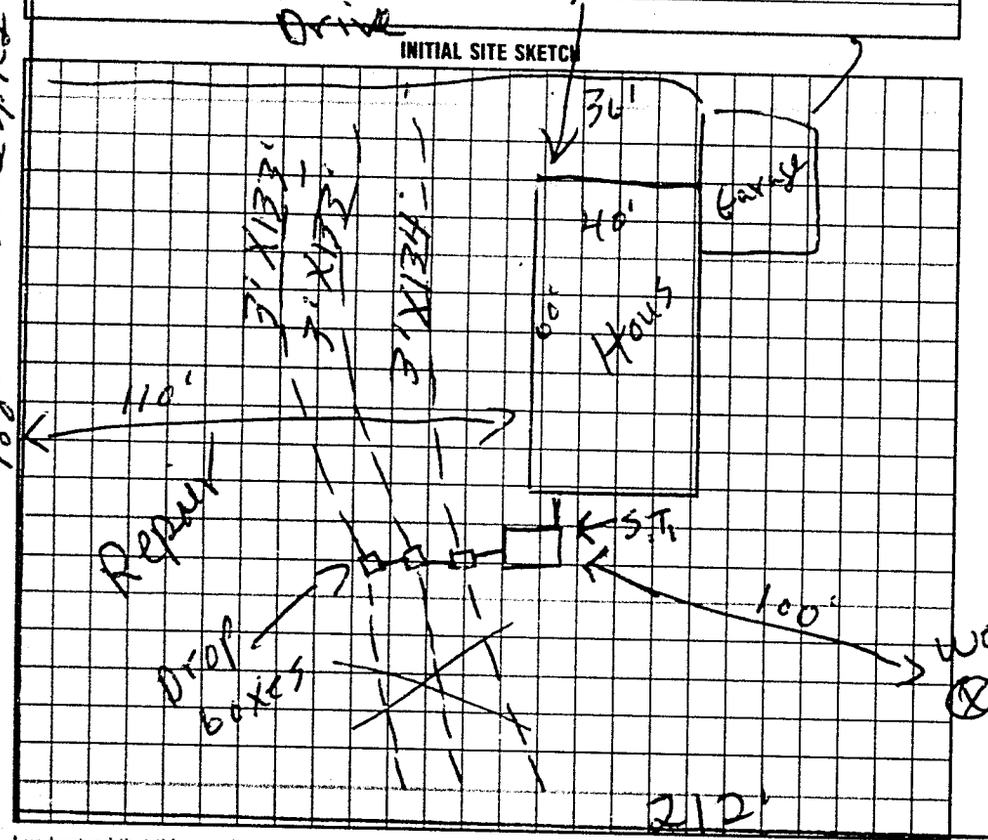

Comments:

Note - Did Not split feed

AS BUILT SKETCH

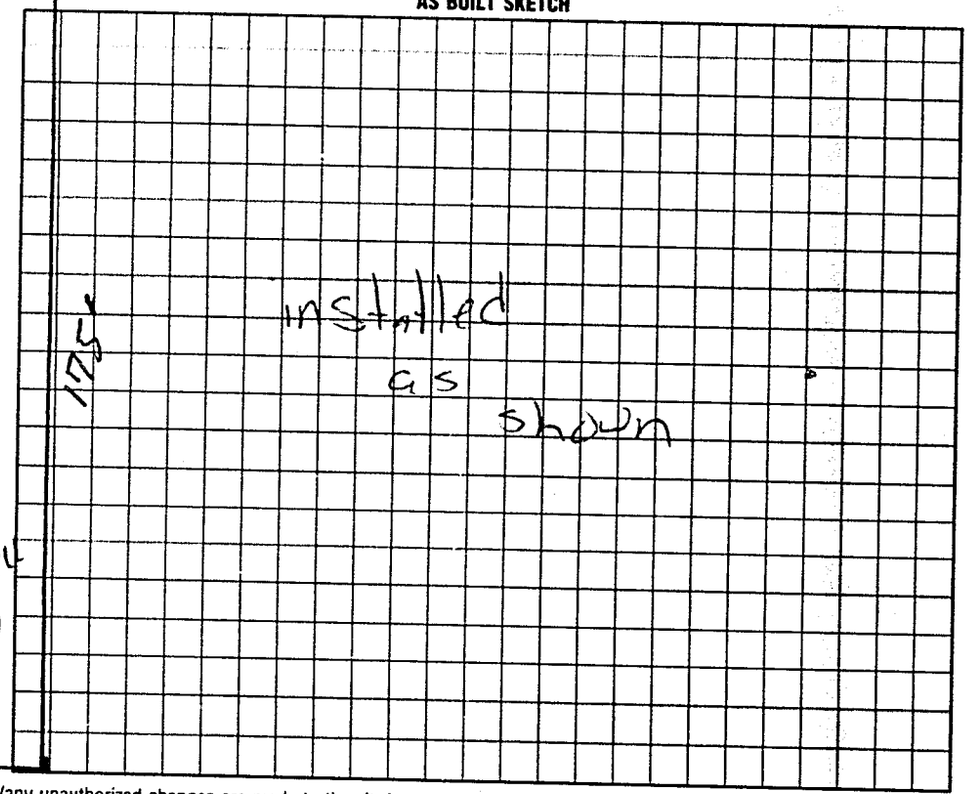

I understand that this permit can be suspended or revoked if any false information is supplied toward securing the permit/any unauthorized changes are made to the site/any unauthorized changes are made in the installation of the system. Improvement Permit is valid for 60 months from date of issuance.

Signed: x Julie Sherrill

Improvement Permit by: F. C. Moore date 4-11-97

~~Existing System Inspection by:~~ Authorization to cover F. C. Moore date 4-11-97

Installed by: A-1 Backhoe

Certificate of Completion by: _____ date _____

Operation Permit by: J Mark C Ouf HS date 1-21-98

Authorization to count EXPIRES 60 mos from issue

HEALTH DEPT COPY: WHITE INSPECTION COPY (FINAL): GREEN OWNER COPY (FINAL): YELLOW INSPECTION COPY (INITIAL): PINK OWNER COPY (INITIAL): GOLD