Not on R/C

IREDELL COUNTY HEALTH DEPARTMENT

Statesville Phone TR 3-7271 Mooresville Phone NO 3-1271

PERMIT TO INSTALL SEPTIC TANK

Permit No. 68 Permit Date 1-19 1972

Owner Leroy Daniels Address

Installed By Robert Hoke Address


Location of Property Last house on Randolph St on left off of Winston ave

Tank		Capacity		Length of Lines		Fixtures	
Block	( )	1000	(✓)	225'	(✓)	No. of Baths	( )
Precast	(✓)	1250	( )	250'	( )	Dishwasher	( )
		1500	( )	Other		Garbage Grdr.	( )
		Other				Other	

NOTIFY HEALTH DEPARTMENT AT LEAST EIGHT HOURS BEFORE TANK IS TO BE INSPECTED.

Final Inspection 1-19 1972 Approved (✓) Disapproved ( )

Remarks

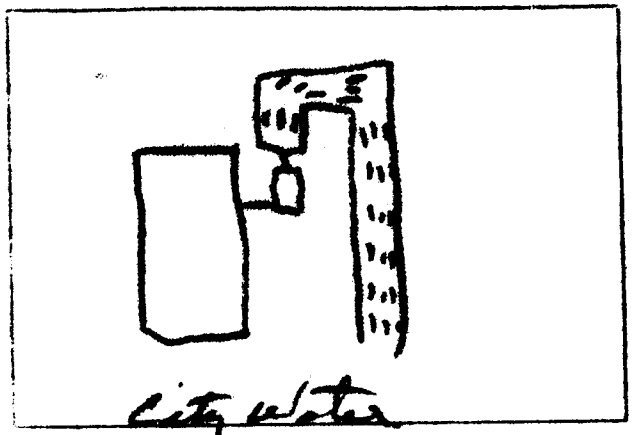

Sketch of Installation

Sanitarian