IREDELL COUNTY HEALTH DEPARTMENT

Statesville Phone TR 3-7271 Mooresville Phone NO 3-1271

PERMIT TO INSTALL SEPTIC TANK

Permit No. _____ Permit Date _____ 19___

Owner A. L. Shaw & Son Address Charlotte Hwy

Installed By S & D Contractors Address Jamestown Road


Location of Property On front of Howard's Fishcamp

Tank		Capacity		Length of Lines		Fixtures	
Block	( )	1000	( )	225'	(✓)	No. of Baths	(1)
Precast	(✓)	1250	(✓)	250'	( )	Dishwasher	( )
		1500	( )	Other _____		Garbage Grdr.	( )
		Other _____				Other _____	

NOTIFY HEALTH DEPARTMENT AT LEAST EIGHT HOURS BEFORE TANK IS TO BE INSPECTED.

Final Inspection 5/27/ 1965 Approved (✓) Disapproved ( )

Remarks _____

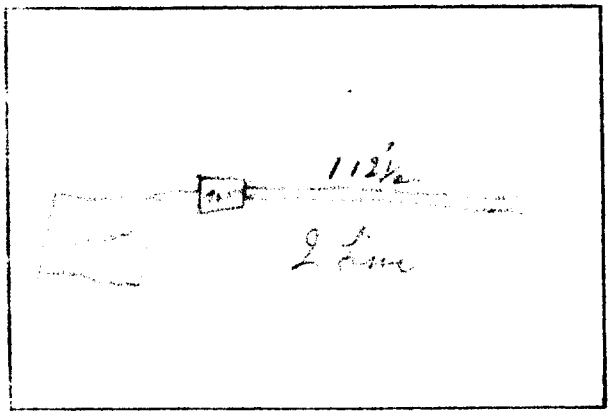

Sketch of Installation

S & D

Sanitarian