IREDELL COUNTY HEALTH DEPARTMENT

STATESVILLE 704-878-5305 MOORESVILLE 704-664-5281

IMPROVEMENT PERMIT / AUTHORIZATION TO CONSTRUCT / OPERATION PERMIT / EXISTING SYSTEM INSPECTION

PERMIT# 128623 PIN# 4733-70-1799 DATE 5-24-05

OWNER OR CONTRACTOR HOMER EDWARDS PHONE: Business Home 704-873-8089

ADDRESS 152 SCHAFER HOLLOW DRIVE, STATESVILLE, NC 28677

LOCATION US 21 SOUTH, TR HILL HAVEN ROAD, 1 LOT ON LEFT AT BOX # 121

SUBDIVISION BLOCK / SECTION LOT LOT AREA 2.777 ACRES SITE CLASS. PS DESIGN FLOW 240 L.T.A.R. EXISTING

Septic Tank: EXISTING Gallons; STB Date

Pump Tank: Gallons; PT Date

Pump Make: Model Serial No.

Nitrification Field: No Fields 1 Square Feet Linear Feet EXISTING

No Lines 1 BED Trench Width Max Trench Bottom Depth

☐ New System ☐ Repair System Type: I, II, III, IV, V, VI

System Description: CONVENTIONAL GRAVITY

Repair System Description:

Maintenance Agreement Required: ☐ Yes ☒ No

Gravel Depth EXISTING ☐ Slab ☑ Crawl Space ☐ Basement w/plumbing ☐ Basement w/plumbing

☐ House/Mod. Home No. Bedrooms 2

☒ Mobile Home No. Bathrooms

☐ Business No. Employees

☐ Other


Water Supply: ☒ Individual ☐ Public ☐ Community WELL

Comments:/Conditions:


Comments:/Conditions:

SYSTEM IS UNDERSIZED ACCORDING TO TODAY'S STANDARDS

INITIAL SITE SKETCH

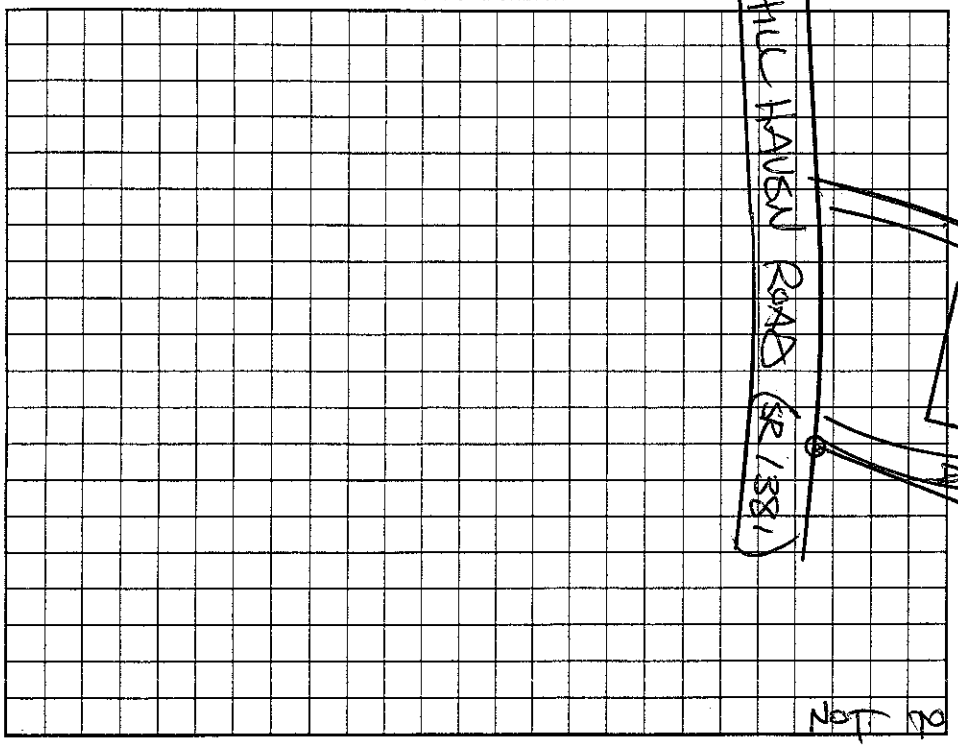

AS BUILT SKETCH

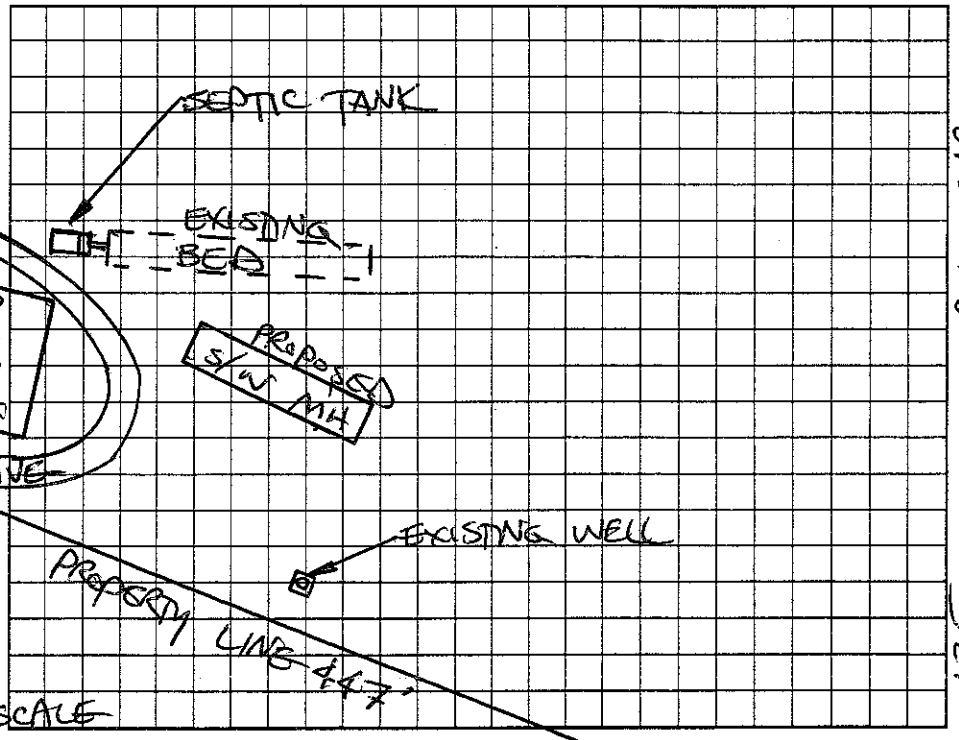

NOT TO SCALE

Permit can be suspended or revoked if any false information is supplied toward securing the permit/any unauthorized changes are made to the site/any unauthorized changes are made in the installation of the system. Improvement Permit with plat valid without expiration. Improvement Permit with site plan valid for sixty months. Authorization to Construct is valid for a period equal to that of Improvement Permit – not to exceed sixty months.

Signed: date Installed by:

Improvement Permit by: date Operation Permit by: date

Authorization to Construct by: date Existing System Inspection by: STEVE HEDRICK date 5-24-05

HEALTH DEPT. COPY: WHITE OWNER COPY (FINAL): YELLOW OWNER COPY (INITIAL): PINK