IREDELL COUNTY HEALTH DEPARTMENT

Statesville Phone TR 3-7271 — Mooresville Phone NO 3-1271

PERMIT TO INSTALL SEPTIC TANK

Permit No. [illegible] — Permit Date July 23 1969

Owner Lary Sigmon — Address R 7 Sta.

Installed By C Hoke & Sons — Address R 7 Sta.


Location of Property South of Howard Fish Camp. Off 21 South on Right

Tank		Capacity		Length of Lines		Fixtures	
Block	( )	1000	(✓)	225'	(✓)	No. of Baths	( )
Precast	(✓)	1250	( )	250'	( )	Dishwasher	( )
Lock		1500	( )	Other		Garbage Grdr.	( )
		Other				Other Trailer	

NOTIFY HEALTH DEPARTMENT AT LEAST EIGHT HOURS BEFORE TANK IS TO BE INSPECTED.

Final Inspection _____ 19__ — Approved (✓) Disapproved ( )

Remarks No well down this date (over)

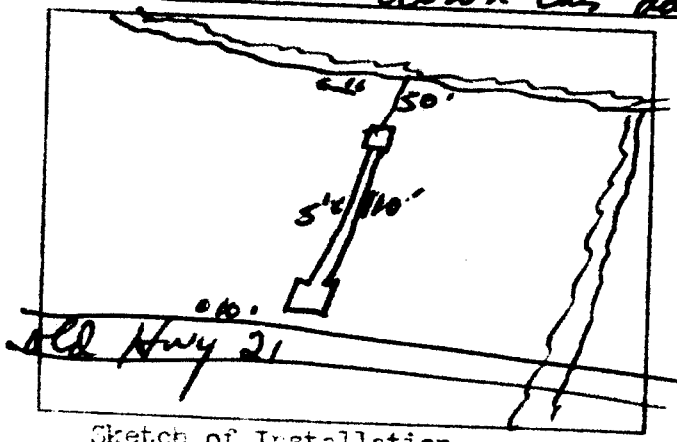

Sketch of Installation

Sanitarian