IREDELL COUNTY HEALTH DEPARTMENT

Statesville Phone TR 3-7271 Mooresville Phone NO 3-1271

PERMIT TO INSTALL SEPTIC TANK

Permit NO. 80 Permit Date DEC 14 1970

Owner J I GRAINGER Address STATESVILLE, N.C

Installed By SAM OSTWALT Address TROUTMAN, N.C.


Location of Property OLD CHARLOTTE ROAD - AT Howards Fish Camp.

Tank		Capacity		Length of Lines		Fixtures	
Block	( )	1000	(✓)	225'	(✓)	No. of Baths	(1)
Precast	(✓)	1250	( )	250'	( )	Dishwasher	( )
		1500	( )	Other		Garbage Grdr.	( )
		Other				Other	

NOTIFY HEALTH DEPARTMENT AT LEAST EIGHT HOURS BEFORE TANK IS TO BE INSPECTED.

Final Inspection DEC 14 1970 Approved (✓) Disapproved ( )

Remarks WATER TABLE HIGH

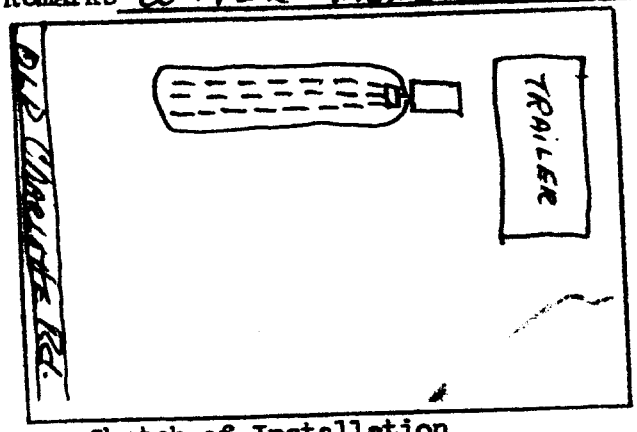

Sketch of Installation

Sanitarian