IREDELL COUNTY HEALTH DEPARTMENT - *ENVIRONMENTAL HEALTH* ☒ STATESVILLE OFFICE 704-878-5305 ☐ MOORESVILLE OFFICE 704-664-5281

IMPROVEMENT PERMIT / AUTHORIZATION TO CONSTRUCT / OPERATION PERMIT / EXISTING SYSTEM INSPECTION

PERMIT # Repair PIN # 4733-75-6603 DATE 11-16-11

OWNER Kathleen Ellis APPLICANT: PHONE: Home/Cell # 704-873-5983 Business # 704-682-1262

SITE ADDRESS 107 Stem Lane OWNER / APPLICANT ADDRESS

SITE DIRECTIONS 64E, (L) Riverhill Rd, (R) Ellis Rd; 1st DW MH on left beside house w/chain link fence

SUBDIVISION n/a (East Mobile Home Park) BLOCK / SECTION LOT # LOT AREA DESIGN FLOW 240 L.T.A.R. .3

Septic Tank 1000 Gallons: STB 760 Date 4-16-11
Pump Tank Gallons: P T Date
Pump Make Model Serial #
No. Nitrification Fields: 1 No. Lines 3 Linear Feet 200
Trench Width 36" Max. Trench Bottom Depth 36" Gravel Depth n/a


☐ New System ☒ Repair ☐ Expansion System Type I II (III) IV V VI
System Description: B
Repair System Description: 25% Reduction Gravity
Maintenance Agreement Required ☐ YES ☒ NO
☒ GRAVITY ☐ PRESSURE

☒ Residence No. Bedrooms 2
☐ Business No. Persons
☐ Other No. Employees
☐ Slab ☒ Crawl Space
☐ Basement w/plumbing ☐ Basement w/o plumbing


Water Supply: ☐ Private ☒ Public ☐ Community

Comments / Conditions
(3) 3' x 66'
Disconnect #(2) from existing system and install new system.
- Repair supply line in existing system for (#)

INITIAL SITE SKETCH

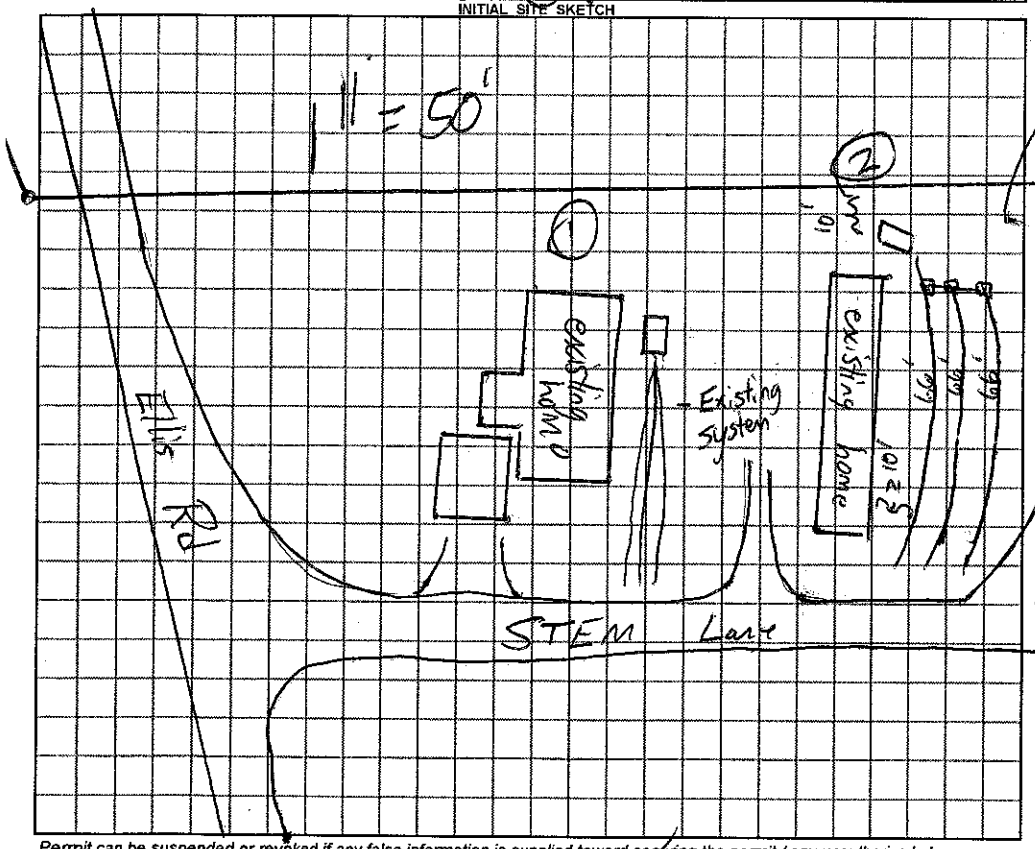

AS BUILT SKETCH

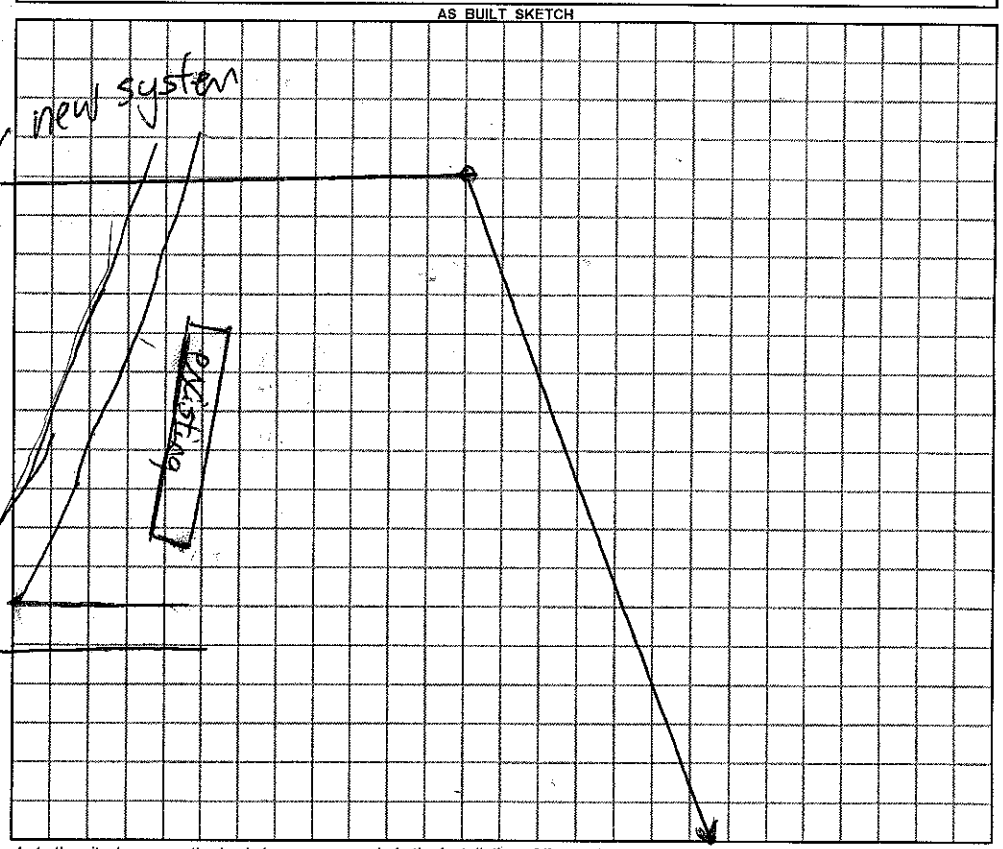

Permit can be suspended or revoked if any false information is supplied toward securing the permit / any unauthorized changes are made to the site / any unauthorized changes are made in the installation of the system.

☐ ***IMPROVEMENT PERMIT*** with plat valid without expiration. ☐ ***IMPROVEMENT PERMIT*** with ~~plat valid without expiration.~~ site plan valid 60 mo. ☒ ***AUTHORIZATION TO CONSTRUCT*** valid for period equal to IMPROVEMENT PERMIT--not to exceed 60 mo.

Owner / Applicant Signature: Date 11-17-11 Installed by: A-1 Backhoe

IMPROVEMENT PERMIT by: REHS Date 11-16-11 OPERATION PERMIT by: REHS Date 12-1-11

AUTHORIZATION TO CONSTRUCT by: REHS Date 11-16-11 Existing System Inspected by: REHS Date

YOU SHOULD CONTACT A LOCATOR SERVICE PRIOR TO ANY EXCAVATION

White Copy -- Environmental Health YELLOW COPY (Final) Owner / Applicant PINK COPY (Initial) Owner / Applicant