IREDELL COUNTY HEALTH DEPARTMENT

Statesville Phone TR 3-7271 Mooresville Phone NO 3-1271

PERMIT TO INSTALL SEPTIC TANK

Permit NO. _____ Permit Date July 15 19 64

Owner Rufus Harris Address Washington Forest

Installed By C Hoke Address _____


Location of Property out Wallace Springs Road past Legion Lot 2nd dirt st. to L. Lot on R 2nd blk.

Tank		Capacity		Length of Lines		Fixtures	
Block	( )	800	( )	150'	( )	No. of Baths	(2)
Precast	(✓)	900	( )	175'	( )	Dishwasher	( )
		1000	(✓)	200'	( )	Garbage Grdr.	( )
		1100	( )	225'	(✓)	Auto-Washer	( )
		1200	( )	250'	( )	Other _____	
		Other _____		Other _____			

NOTIFY HEALTH DEPARTMENT AT LEAST EIGHT HOURS BEFORE TANK IS TO BE INSPECTED.

Final Inspection 7-15 1964 Approved (✓) Disapproved ( )

Remarks Central water Supply - drive crossed lines - not to be used for Permant traffic. Owner understands. line very deep due to fall of ground. and narrow lot.

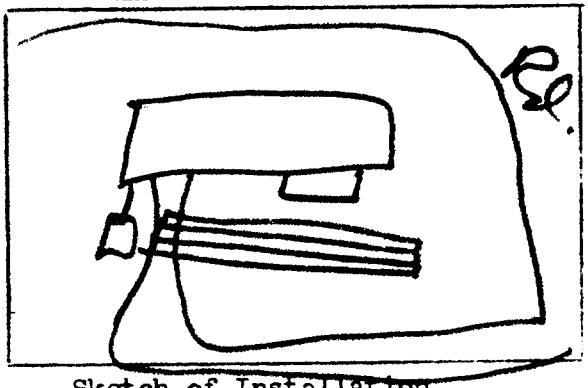

Sketch of Installation

Sanitarian